IREDELL COUNTY HEALTH DEPARTMENT

Statesville Phone TR 3-7271 Mooresville Phone No. 664-5281

PERMIT TO INSTALL SEPTIC TANK

Permit No. [illegible] Permit Date 2-13 1973

Owner M & F. Sales Address Statesville NC

Installed By Harlee Lackey Address Stony Point NC.


Location of Property Hwy # 90 T.R. at Kuns Grs on Rd # 1546. T.R. into Grayson Park. 7th trailer on L Lot # 17

Tank		Capacity		Length of Lines		Fixtures	
Block	( )	1000	(✓)	225'	(✓)	No. of Baths	(1)
Precast	(✓)	1250	( )	250'	( )	Dishwasher	( )
		1500	( )	Other		Garbage Grdr.	( )
		Other				Other	

NOTIFY HEALTH DEPARTMENT AT LEAST EIGHT HOURS BEFORE TANK IS TO BE INSPECTED.

Final Inspection 2-13 1973 Approved (✓) Disapprcved ( )

Remarks Community Water

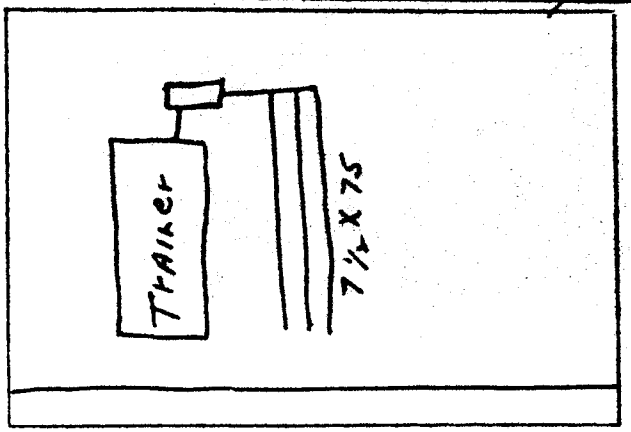

Sketch of Installation

E. G. Stevenson

Sanitarian