IREDELL COUNTY HEALTH DEPARTMENT

Statesville Phone TR 3-7271 Mooresville Phone NO 3-1271

PERMIT TO INSTALL SEPTIC TANK

Permit No. 133 Permit Date 6-16 1972

Owner Frank Dejarlais M+T Sales Address Statesville NC

Installed By Harlee Lackey Address Stony Point

Location of Property out Hwy 90 to Kems Gro

T.R. on 1546 Trailer Park on R


9th Trailer on R. 1st St Grayson Park.

| Tank | | Capacity | | Length of Lines | | Fixtures | |
|---|---|---|---|---|---|---|---|
| Block | ( ) | 1000 | (✓) | 225' | (✓) | No. of Baths | (1) |
| Precast | (✓) | 1250 | ( ) | 250' | ( ) | Dishwasher | ( ) |
| | | 1500 | ( ) | Other | | Garbage Grdr. | ( ) |
| | | Other | | | | Other | |

NOTIFY HEALTH DEPARTMENT AT LEAST EIGHT HOURS BEFORE TANK IS TO BE INSPECTED.

Final Inspection 6-16 1972 Approved (✓) Disapproved ( )

Remarks Community Water

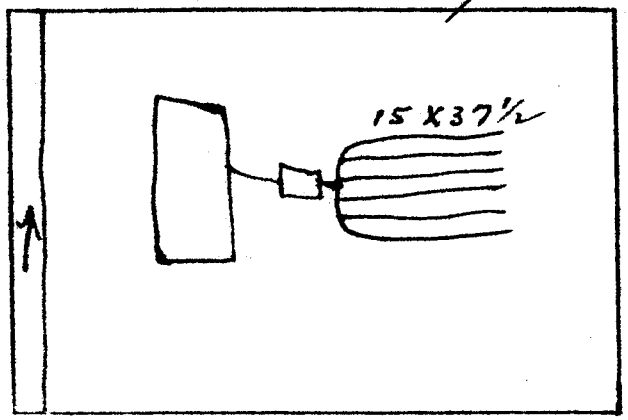


Sketch of Installation

Lot # 9

E. A. Stevenson

Sanitarian