IREDELL COUNTY HEALTH DEPARTMENT

Statesville Phone TR 3-7271 Mooresville Phone No. 664-5281

PERMIT TO INSTALL SEPTIC TANK

Permit No. ____ Permit Date 6-22 1973

Owner M & J Sales Address Statesville

Installed By Hankins Builders Address Statesville, NC


Location of Property Grayson Park Off Highway 90 W - 4th on Left before creek - Lot #18

Tank		Capacity		Length of Lines		Fixtures	Trailer
Block	( )	1000	( )	225'	(✓)	No. of Baths	( )
Precast	(✓)	1250	( )	250'	( )	Dishwasher	( )
		1500	( )	Other ____		Garbage Grdr.	( )
		Other ____				Other ____	

NOTIFY HEALTH DEPARTMENT AT LEAST EIGHT HOURS BEFORE TANK IS TO BE INSPECTED.

Final Inspection 6-22 1973 Approved (✓) Disapproved ( )

Remarks Community Water Supply

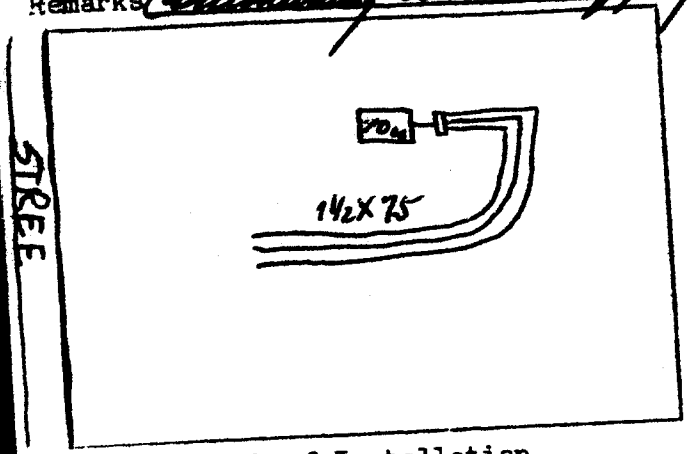

Sketch of Installation

Glenn Fisher
Sanitarian