IREDELL COUNTY HEALTH DEPARTMENT

Statesville Phone TR 3-7271 Mooresville Phone No. 664-5281

PERMIT TO INSTALL SEPTIC TANK

Permit No. 70 Permit Date 6-22 1973

Owner M+J Sales Address Statesville, NC

Installed By Henkels Bldg Co. Address Statesville, NC

Location of Property Simpson Park - Highway 90W -


3rd on Left from crek Lot # 19

Tank		Capacity		Length of Lines		Fixtures TRAILERS	
Block	( )	1000	(✓)	225'	(✓)	No. of Baths	(✓)
Precast	(✓)	1250	( )	250'	( )	Dishwasher	( )
		1500	( )	Other		Garbage Grdr.	( )
		Other				Other	

NOTIFY HEALTH DEPARTMENT AT LEAST EIGHT HOURS BEFORE TANK IS TO BE INSPECTED.

Final Inspection 6-22 1973 Approved (✓) Disapproved ( )

Remarks Community Water Supply

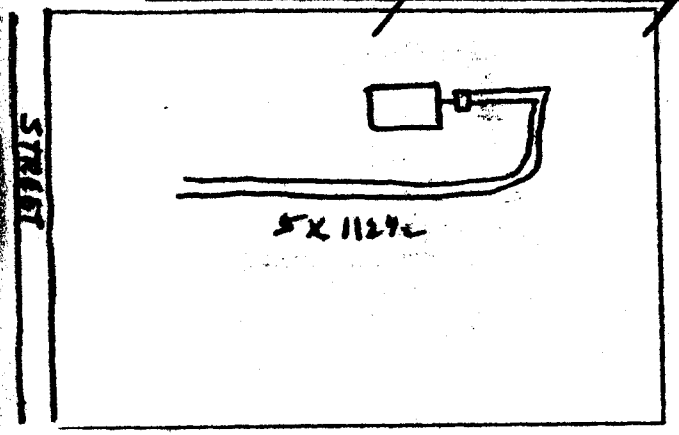

Sketch of Installation

Sanitarian