IREDELL COUNTY HEALTH DEPARTMENT

Statesville Phone TR 3-7271 Mooresville Phone No. 664-5281

PERMIT TO INSTALL SEPTIC TANK

Permit No. [illegible] Permit Date 7-10 1973

Owner M & F SALES - GRAYSON PARK Address STATESVILLE, N.C.

Installed By ICENHOUR BLDG. CO. Address STATESVILLE, N.C.


Location of Property TAYLORSVILLE Rd. on Rt. North of International Paper. Kuiwood Div. 2nd on LEFT from Branch. Lot #20

Tank		Capacity		Length of Lines		Fixtures	
Block	( )	1000	(✓)	225'	(✓)	No. of Baths	(✓)
Precast	(✓)	1250	( )	250'	( )	Dishwasher	( )
		1500	( )	Other		Garbage Grdr.	( )
		Other				Other	

NOTIFY HEALTH DEPARTMENT AT LEAST EIGHT HOURS BEFORE TANK IS TO BE INSPECTED.

Final Inspection 7-10 1973 Approved (✓) Disapproved ( )

Remarks COMMUNITY WATER SUPPLY

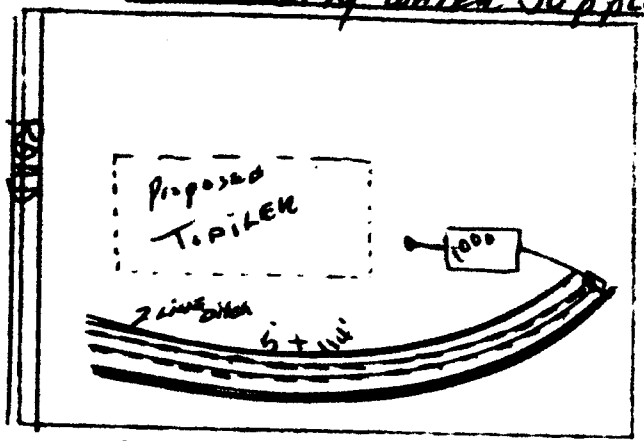

Sketch of Installation

Sanitarian