IREDELL COUNTY HEALTH DEPARTMENT

Statesville Phone TR 3-7271 Mooresville Phone No. 664-5281

PERMIT TO INSTALL SEPTIC TANK

Permit No. 476 Permit Date 7-10 1973

Owner M & F Sales - Grayson Park Address Statesville, N.C.

Installed By Leenhour Bldg Co. Address Statesville, N.C.

Location of Property Taylorsville Rd - on Rt. North of.

International Paper Univood Div.


1st on left from Branch. Lot # 20 A

Tank		Capacity		Length of Lines		Fixtures	
Block	( )	1000	(✓)	225'	(✓)	No. of Baths	(1)
Precast	(✓)	1250	( )	250'	( )	Dishwasher	( )
		1500	( )	Other		Garbage Grdr.	( )
		Other				Other	

NOTIFY HEALTH DEPARTMENT AT LEAST EIGHT HOURS BEFORE TANK IS TO BE INSPECTED.

Final Inspection 7-10 1973 Approved (✓) Disapproved ( )

Remarks Community House.

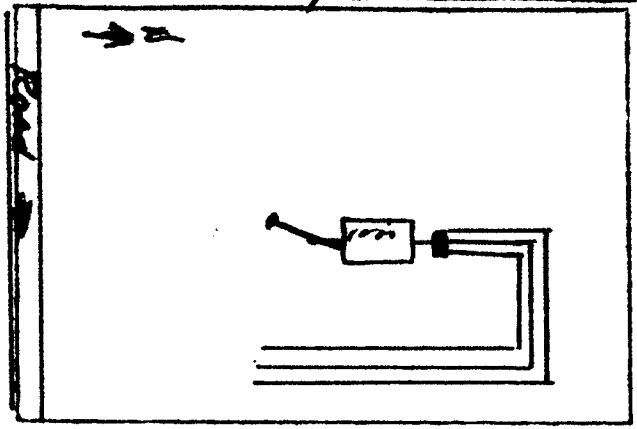

Sketch of Installation

Sanitarian