# IREDELL COUNTY HEALTH DEPARTMENT

STATESVILLE 704-878-5305 MOORESVILLE 704-664-5281

## IMPROVEMENT PERMIT / AUTHORIZATION TO CONSTRUCT / OPERATION PERMIT / EXISTING SYSTEM INSPECTION

PERMIT# 125656 PIN# 4725-37-2186 DATE 4-20-05

OWNER OR CONTRACTOR ROBERT EUGENE FOX PHONE: Business 704-682-2597 Home 704-872-4372

ADDRESS 168 FAMILY CIRCLE STATESVILLE

LOCATION NC 90 WEST, TR GRAYSON PARK ROAD, TR 2ND FAMILY CIRCLE, 3RD HOUSE ON LEFT

SUBDIVISION GRAYSON PARK BLOCK / SECTION ____ LOT 4A LOT AREA 0.46 ACRE SITE CLASS PS DESIGN FLOW 240 L.T.A.R. EXISTING

Septic Tank: 1000 Gallons; STB ____ Date ____

Pump Tank: ____ Gallons; PT ____ Date ____

Pump Make: ____ Model ____ Serial No. ____

Nitrification Field: No Fields 1 Square Feet 600 Linear Feet 200

No Lines TWO Trench Width 36 Max Trench Bottom Depth DEED Gravel Depth 10"

☐ New System ☐ Repair System Type: I, II, III, IV, V, VI

System Description: CONVENTIONAL, GRAVITY

Repair System Description: ____

Maintenance Agreement Required: ☐ Yes ☒ No

☐ House/Mod. Home ☒ Mobile Home ☐ Business ☐ Other

No. Bedrooms 2 No. Bathrooms ____ No. Employees ____


☐ Slab ☐ Crawl Space ☐ Basement w/plumbing ☐ Basement wo/plumbing

Water Supply: ☐ Individual ☒ Public ☒ Community


Comments:/Conditions:

Comments:/Conditions: SYSTEM SIZED FOR 2 BEDROOMS ONLY - UNDERSIZED ACCORDING TO TODAY'S STANDARDS

INITIAL SITE SKETCH

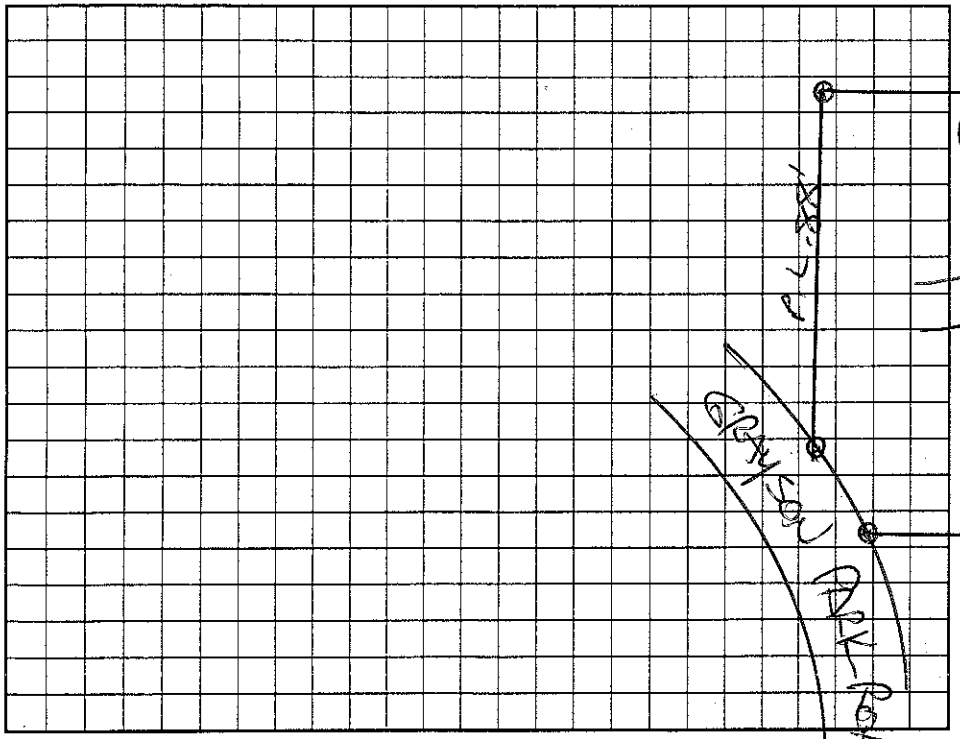


AS BUILT SKETCH

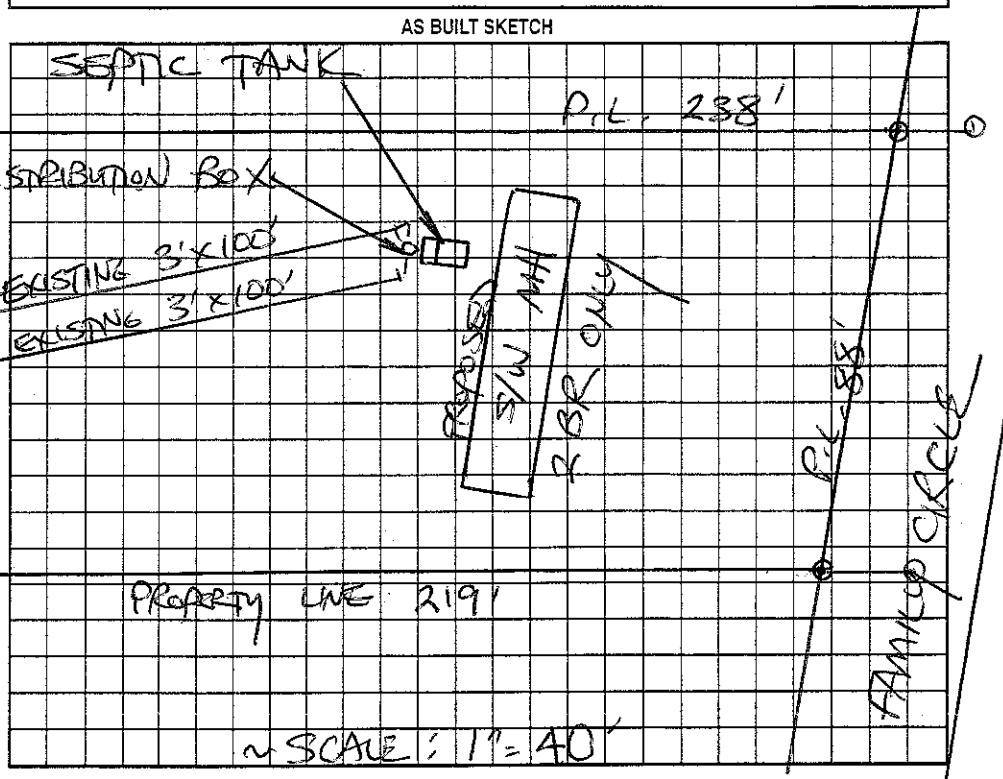


Permit can be suspended or revoked if any false information is supplied toward securing the permit/any unauthorized changes are made to the site/any unauthorized changes are made in the installation of the system. Improvement Permit with plat valid without expiration. Improvement Permit with site plan valid for sixty months. Authorization to Construct is valid for a period equal to that of Improvement Permit – not to exceed sixty months.

Signed: ____ date ____ Installed by: ____

Improvement Permit by: ____ date ____ Operation Permit by: ____ date ____

Authorization to Construct by: ____ date ____ Existing System Inspection by: STEVE HEDRICK date 4-20-05

HEALTH DEPT. COPY: WHITE OWNER COPY (FINAL): YELLOW OWNER COPY (INITIAL): PINK