12-30

IREDELL COUNTY HEALTH DEPARTMENT - *ENVIRONMENTAL HEALTH* ☑ STATESVILLE OFFICE 704-878-5305 ☐ MOORESVILLE OFFICE 704-664-5281

IMPROVEMENT PERMIT / AUTHORIZATION TO CONSTRUCT / OPERATION PERMIT / EXISTING SYSTEM INSPECTION

PERMIT # REPAIR PIN # 4725-37-3176 DATE MARCH 20 2012

OWNER ROBERT EUGENE FOX APPLICANT: SAME PHONE: Home/Cell # 704-682-2597 Business #

SITE ADDRESS 166 FAMILY CIRCLE OWNER / APPLICANT ADDRESS 272 OLD MILLER RD STATESVILLE, NC 28625-1638

SITE DIRECTIONS NC 90 W TR GRAYSON PARK RD, TR FAMILY CIRCLE (2ND), MH ON LEFT, AT BOX #166

SUBDIVISION GRAYSON PARK BLOCK / SECTION LOT # 5 LOT AREA 82'X244' DESIGN FLOW 360 L.T.A.R. 0.30 GPD/FT2

Septic Tank 1000 Gallons: STB Date

Pump Tank Gallons: P T Date

Pump Make Model Serial #

No. Nitrification Fields: 1 No. Lines 2 Linear Feet 200

Trench Width 36" Max. Trench Bottom Depth 36" +/- Gravel Depth N/A

☐ New System ☑ Repair ☐ Expansion System Type I II (III) IV V VI

System Description:

Repair System Description: 25% REDUCTION, GRAVITY

Maintenance Agreement Required ☐ YES ☑ NO

☑ GRAVITY ☐ PRESSURE

☑ Residence No. Bedrooms 3

☐ Business No. Persons

☐ Other No. Employees


☐ Slab ☑ Crawl Space

☐ Basement w/plumbing ☐ Basement w/o plumbing

Water Supply: ☐ Private ☑ Public ☐ Community

Comments / Conditions: INSTALL NEW DISTRIBUTION BOX AS SHALLOW AS POSSIBLE. INSTALL TWO (2) NEW 3'X100' DRAINLINES USING 25% REDUCTION. USE SPEED LEVELERS TO FEED NEW LINES FIRST.

INITIAL SITE SKETCH

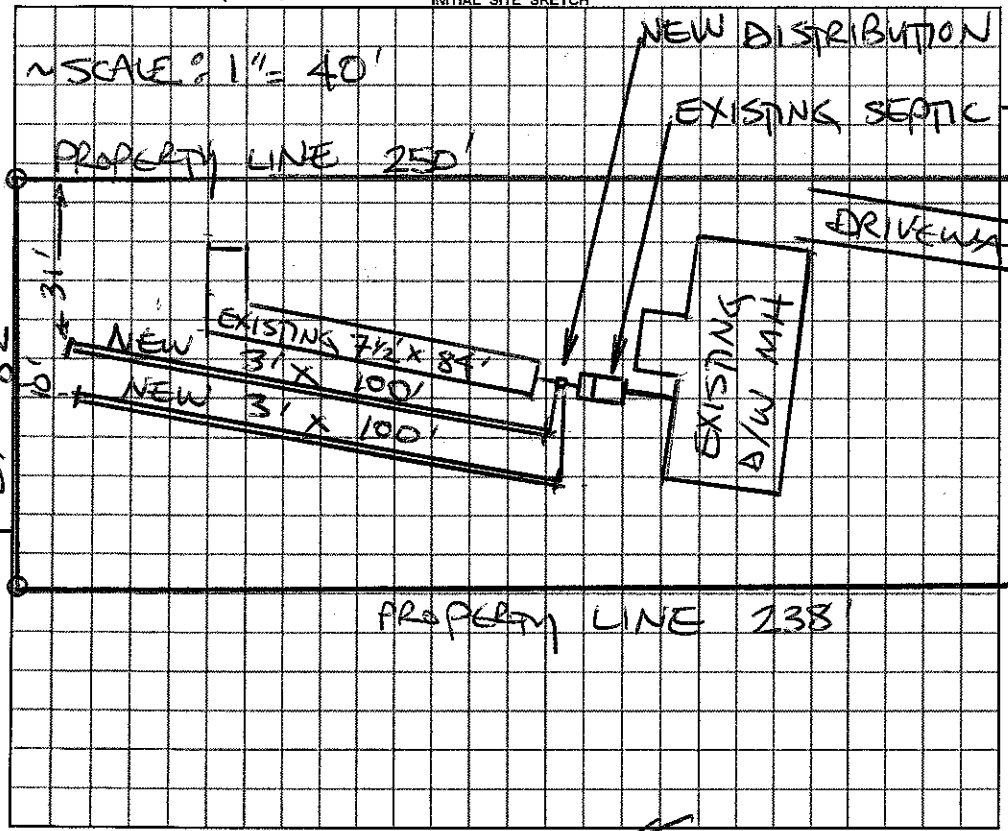

AS BUILT SKETCH

- Leak noted at time of final
- fix leak or system will likely have continued issues

Permit can be suspended or revoked if any false information is supplied toward securing the permit / any unauthorized changes are made to the site / any unauthorized changes are made in the installation of the system.

☐ ***IMPROVEMENT PERMIT*** *with plat valid without expiration.* ☑ ***IMPROVEMENT PERMIT*** *with plat valid without expiration. site plan valid 60 mo.* ☑ ***AUTHORIZATION TO CONSTRUCT*** valid for period equal to IMPROVEMENT PERMIT—not to exceed 60 mo.

Owner / Applicant Signature: Robert A Date 3-21-2012 Installed by: Yountz Grading

IMPROVEMENT PERMIT by: STEVE HEDRICK REHS Date 3/20/2012 OPERATION PERMIT by: REHS Date 3-29-12

AUTHORIZATION TO CONSTRUCT by: STEVE HEDRICK REHS Date 3/20/2012 Existing System Inspected by: REHS Date

YOU SHOULD CONTACT A LOCATOR SERVICE PRIOR TO ANY EXCAVATION

White Copy – Environmental Health YELLOW COPY (Final) Owner / Applicant PINK COPY (Initial) Owner / Applicant