IREDELL COUNTY HEALTH DEPARTMENT

STATESVILLE 704-878-5305 MOORESVILLE 704-664-5281

IMPROVEMENT PERMIT / AUTHORIZATION TO CONSTRUCT / OPERATION PERMIT / EXISTING SYSTEM INSPECTION

PERMIT# REPAIR PIN# 4725-37-6140 DATE 6-15-06

OWNER OR APPLICANT ROBERT FOX PHONE: Business 704-682-2597 Home 704-872-4372

ADDRESS 272 OLD MILLER ROAD, STATESVILLE, NC 28625-1638

LOCATION ~~272 OLD MILLER RD, S~~ NC90 W, TR GRAYSON PARK, TR 2ND FAMILY CIR, LOT ON LEFT AT CURVE

SUBDIVISION GRAYSON PARK BLOCK / SECTION ____ LOT 8A LOT AREA 1 ACRE SITE CLASS. PS DESIGN FLOW 360 L.T.A.R. 0.40 GPD/FT²

Septic Tank: EXISTING Gallons: STB ____ Date ____

Pump Tank: ____ Gallons: PT ____ Date ____

Pump Make: ____ Model ____ Serial No. ____

Nitrification Field: No Fields 1 Square Feet 960 Linear Feet 240

No Lines TWO Trench Width 36" Max Trench Bottom Depth 36" Gravel Depth N/A

☒ New System ☒ Repair ☐ Expansion System Type: I (II) III IV V VI

System Description: ____

Repair System Description: 25% REDUCTION

Maintenance Agreement Required: ☐ Yes ☒ No GRAVITY

☐ Gravity ☐ Pressure

☐ House/Mod. Home ☒ Mobile Home ☐ Business ☐ Other

No. Bedrooms 3 No. Persons ____ No. Employees ____


☐ Slab ☒ Crawl Space ☐ Basement w/plumbing ☐ Basement wo/plumbing

Water Supply: ☐ Individual ☒ Public ☐ Community


Comments/Conditions: ① INSTALL NEW 3' x 120' LINES (TWO) USING 25% REDUCTION SYSTEM AS FLAGGED ② ABANDON EXISTING LINES UNDER S/W MH.

Comments/Conditions:

INITIAL SITE SKETCH

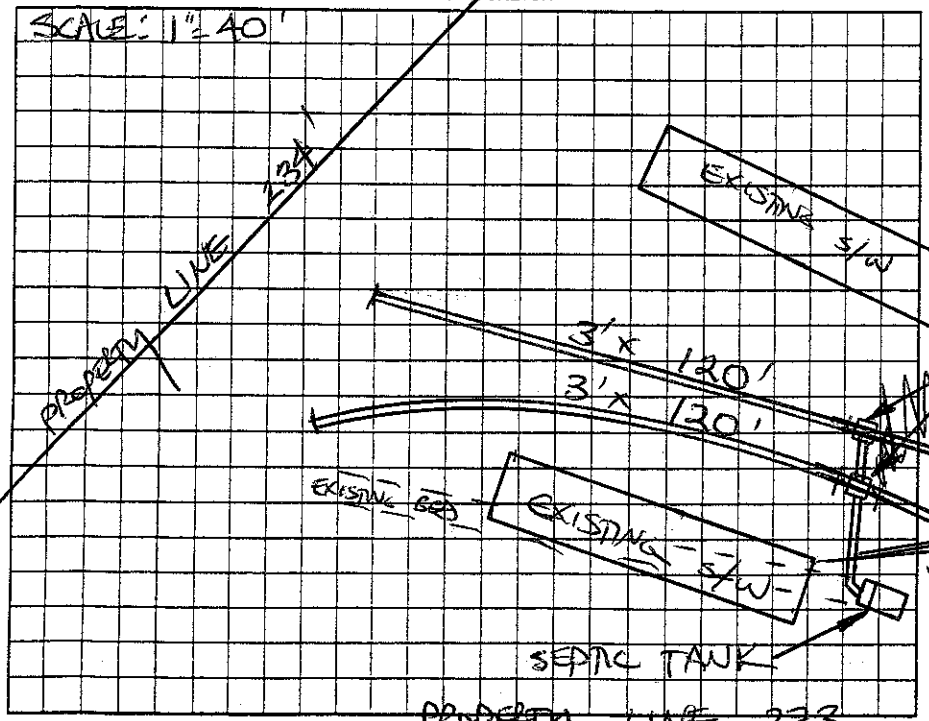

AS BUILT SKETCH

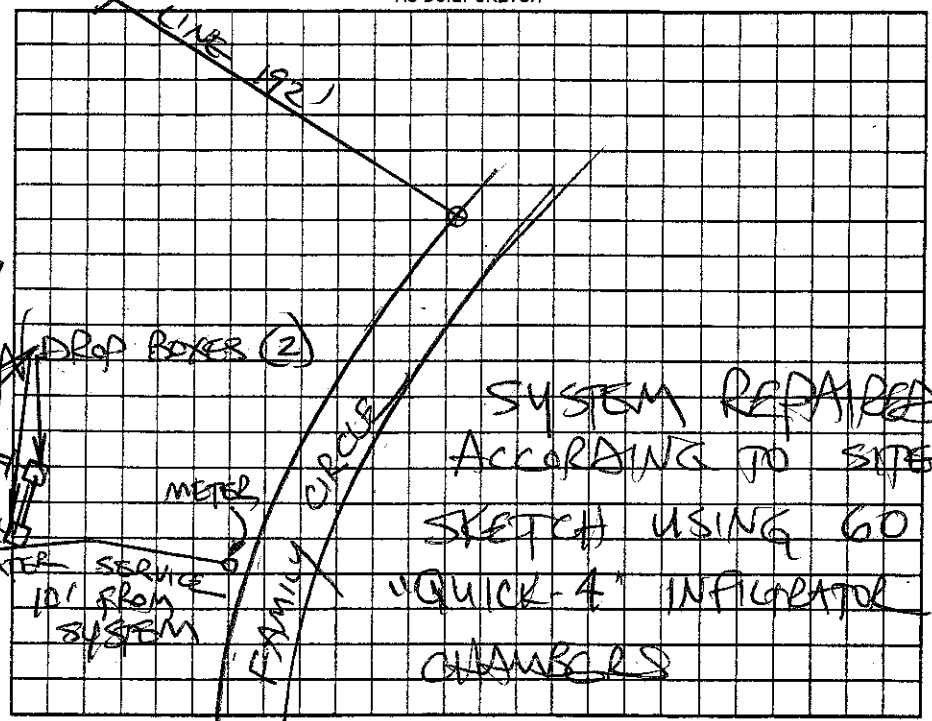

Permit can be suspended or revoked if any false information is supplied toward securing the permit/any unauthorized changes are made to the site/any unauthorized changes are made in the installation of the system. Improvement Permit with plan valid without expiration ☐ Improvement Permit with site plan valid for sixty months ☒ Authorization to Construct is valid for a period equal to that of Improvement Permit – not to exceed sixty months.

Signed: [signature] date 6-15-06 Installed by: JAMES HUNTER

Improvement Permit by: STEVE HEDRICK date 6-15-06 Operation Permit by: STEVE HEDRICK date 6-22-06

Authorization to Construct by: STEVE HEDRICK date 6-15-06 Existing System Inspection by: ____ date ____

HEALTH DEPT. COPY: WHITE OWNER COPY (FINAL): YELLOW OWNER COPY (INITIAL): PINK