IREDELL COUNTY HEALTH DEPARTMENT

STATESVILLE 704-878-5305 MOORESVILLE 704-664-5281

55690

IMPROVEMENT PERMIT / CERTIFICATE OF COMPLETION / OPERATION PERMIT / EXISTING SYSTEM INSPECTION

PROPERTY DESCRIPTION NO. 19892 DATE 4/20/95 TAX MAP NO. 9D-13-A-26 Watershed: ☐ Yes ☒ No

OWNER OR CONTRACTOR SAM PARKS PHONE: Business _____ Home 873-0080

ADDRESS 120 IVANHOE LN, STATESVILLE, NC 28677

LOCATION NC 90W, TR MONTGOMERY, TL MILLER FARM, TL BEECHBROOK, LOT ON LEFT AT CUL-DE-SAC

SUBDIVISION PINEY OAKS BLOCK / SECTION _____ LOT 26 LOT AREA 130x275' SITE CLASS. PS DESIGN FLOW 360 L.T.A.R. 0.306 GPD/SF

Septic Tank: 1000 Gallons; STB 1012 Date 4-14-96

Pump Tank: _____ Gallons; PT _____ Date _____

Pump Make: _____ Model _____ Serial No. _____

Nitrification Field: No Fields 1 Square Feet 1200 Linear Feet 400

No Lines 3 Trench Width 36" Max Trench Bottom Depth 18-36 Gravel Depth 12"

☒ New System ☐ Repair System Type: I, II, III, IV, V, VI

System Description: CONV. GRAVITY

Repair System Description: CONV. PUMP

Maintenance Agreement Required: ☐ Yes ☒ No

☒ House/Mod. Home No. Bedrooms 3

☐ Mobile Home No. Bathrooms 2½

☐ Business No. Employees _____

☐ Other _____


☐ Slab ☒ Crawl Space ☐ Basement w/plumbing ☐ Basement wo/plumbing

Water Supply: ☐ Individual ☐ Community ☒ Public


Comments:

Comments:

INITIAL SITE SKETCH

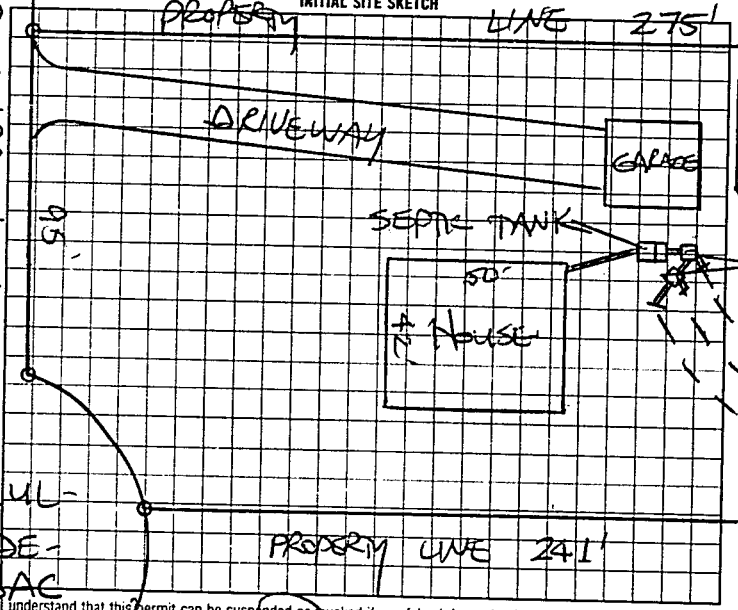

AS BUILT SKETCH

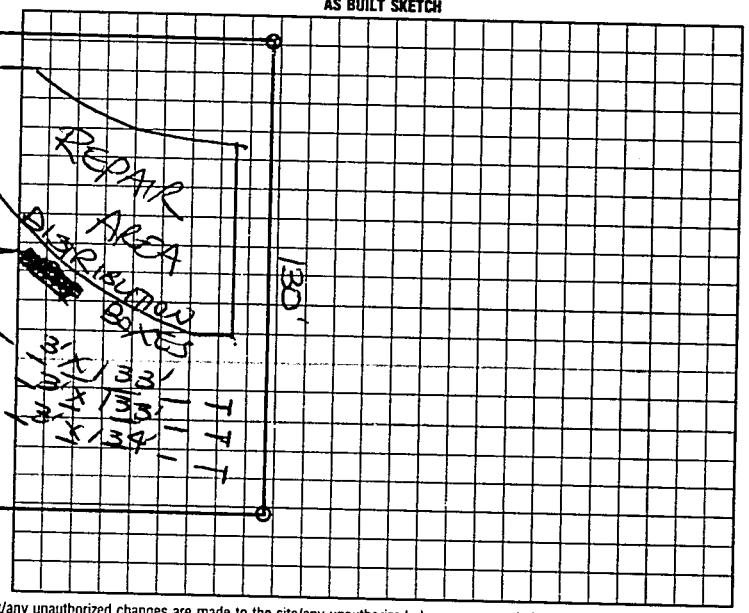

I understand that this permit can be suspended or revoked if any false information is supplied toward securing the permit/any unauthorized changes are made to the site/any unauthorized changes are made in the installation of the system. Improvement Permit is valid for 60 months from date of issuance.

Signed: I Sam Parks

Improvement Permit by: STEVE HEDRICK date 4/20/95

Existing System Inspection by: _____ date _____

Installed by: DAVID YOUNTZ

Certificate of Completion by: _____ date _____

Operation Permit by: STEVE HEDRICK date 6-28-96

HEALTH DEPT. COPY WHITE INSPECTION COPY (FINAL) GREEN OWNER COPY (FINAL) YELLOW INSPECTION COPY (INITIAL) PINK OWNER COPY (INITIAL) GOLD