IREDELL COUNTY HEALTH DEPARTMENT

STATESVILLE 704-878-5305 MOORESVILLE 704-664-5281

52681

IMPROVEMENT PERMIT / CERTIFICATE OF COMPLETION / OPERATION PERMIT / EXISTING SYSTEM INSPECTION

PROPERTY DESCRIPTION NO. 18947 DATE 8/25/94 TAX MAP NO. 9D-13-A-28 Watershed: ☐ Yes ☑ No

OWNER OR CONTRACTOR ACORN DEVELOPMENT CO, INC PHONE: Business 872-0072 Home

ADDRESS P.O. BOX 5671 STATESVILLE NC 28677

LOCATION NC 90 WEST, TR MONTICELLO, TL MILLER FARM, TL BEECH BROOK LN, LOT ON LEFT

SUBDIVISION PINEY OAKS BLOCK / SECTION LOT 28 LOT AREA ~130' X 241' SITE CLASS. PS DESIGN FLOW 360 L.T.A.R. 0.35 GPD/FT²

Septic Tank: 1000 Gallons; STB 794 Date 3/27/95

Pump Tank: Gallons; PT Date

Pump Make: Model Serial No.

Nitrification Field: No Fields 1 Square Feet 1035 Linear Feet 345

No Lines 4 Trench Width 36" Max Trench Bottom Depth 18-36" Gravel Depth 12"

☑ New System ☐ Repair System Type: I, II, III, IV, V, VI

System Description: CONVENTIONAL GRAVITY

Repair System Description: CONV. GRAVITY

Maintenance Agreement Required: ☐ Yes ☑ No

☑ House/Mod. Home No. Bedrooms 3

☐ Mobile Home No. Bathrooms 2

☐ Business No. Employees

☐ Other


☐ Slab ☑ Crawl Space ☐ Basement w/plumbing ☐ Basement wo/plumbing

Water Supply: ☐ Individual ☐ Community ☑ Public

Comments: ① KEEP SYSTEM MINIMUM 5' FROM HOUSE, 10' FROM PROPERTY LINE, 10' FROM WATER LINE. ② INSTALL LINES ON CONTOUR, NO DEEPER THAN 36", 9' APART MINIMUM ON CENTERS.

Comments:

INITIAL SITE SKETCH

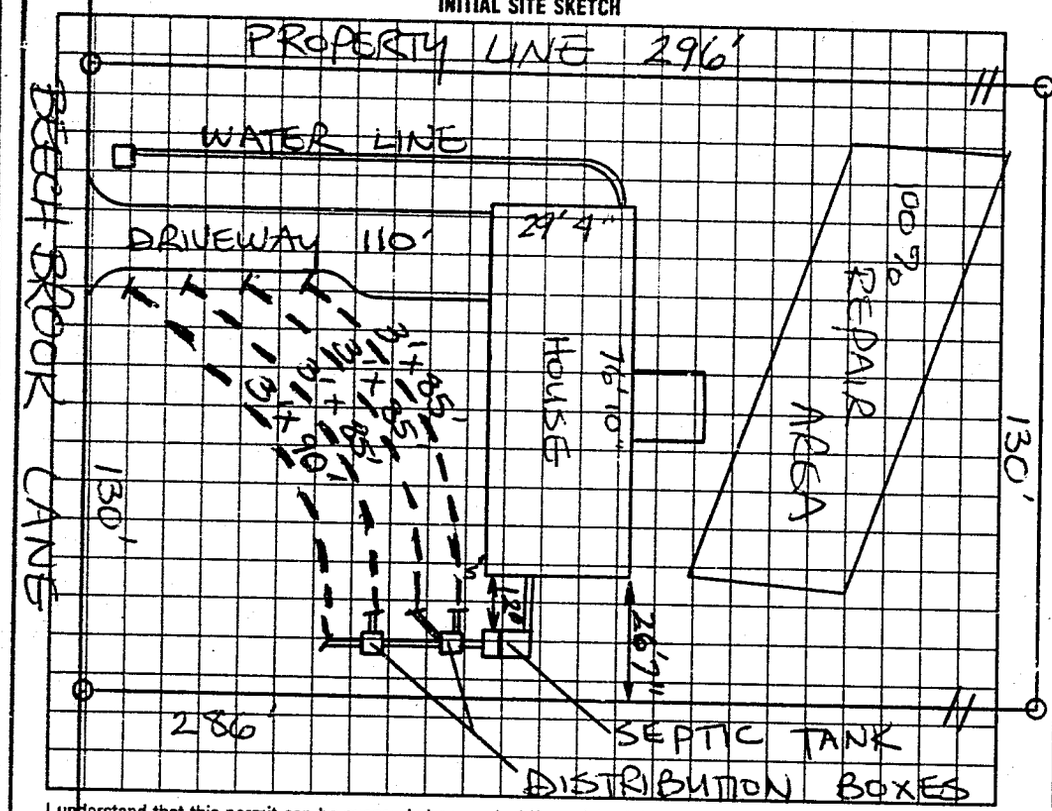

AS BUILT SKETCH

SYSTEM INSTALLED ACCORDING TO INITAL SITE SKETCH

I understand that this permit can be suspended or revoked if any false information is supplied toward securing the permit/any unauthorized changes are made to the site/any unauthorized changes are made in the installation of the system. Improvement Permit is valid for 60 months from date of issuance.

Signed: X Thomas J. White

Improvement Permit by: STEVE HEDRICK date 8/25/94

Existing System Inspection by: date

Installed by: JAMES HUDLER

Certificate of Completion by: STEVE HEDRICK date 5/5/95

Operation Permit by: date

HEALTH DEPT COPY: WHITE INSPECTION COPY (FINAL): GREEN OWNER COPY (FINAL): YELLOW INSPECTION COPY (INITIAL): PINK OWNER COPY (INITIAL): GOLD