IREDELL COUNTY HEALTH DEPARTMENT

STATESVILLE 704-878-5305 MOORESVILLE 704-664-5281

48911

IMPROVEMENT PERMIT / CERTIFICATE OF COMPLETION / OPERATION PERMIT / EXISTING SYSTEM INSPECTION

PROPERTY DESCRIPTION NO. 14434 DATE 6/10/94 TAX MAP NO. 9B-13-A-30 Watershed: ☐ Yes ☒ No

OWNER OR CONTRACTOR ACORN DEV. INC. PHONE: Business Home 872-0072

ADDRESS P.O. BOX 5671, STVL NC 28687

LOCATION NC90W TO MONTICELLO, TL MILLER FARM TL, BEECH BROOK LN, LOT NEAR END ON (L)

SUBDIVISION PINEY OAKS BLOCK / SECTION LOT 30 LOT AREA ~130'X311' SITE CLASS. PS DESIGN FLOW 360 L.T.A.R. 0.35 GPD/FT2

Septic Tank: 1000 Gallons; STB 1012 Date 3/21/94

Pump Tank: Gallons; PT Date

Pump Make: Model Serial No.

Nitrification Field: No Fields 1 Square Feet 1035 Linear Feet 345

No Lines 3 Trench Width 36" Max Trench Bottom Depth 18-36 Gravel Depth 12"

☒ New System ☐ Repair System Type: I II III IV V VI

System Description: CONV. GRAVITY

Repair System Description: CONV. GRAVITY

Maintenance Agreement Required: ☐ Yes ☒ No

☒ House/Mod. Home ☐ Mobile Home ☐ Business ☐ Other

No. Bedrooms 3 No. Bathrooms 2 No. Employees

☐ Slab ☒ Crawl Space ☐ Basement w/plumbing ☐ Basement wo/plumbing


Water Supply: ☐ Individual ☐ Community ☒ Public

Comments:

INITIAL SITE SKETCH

Comments:

AS BUILT SKETCH

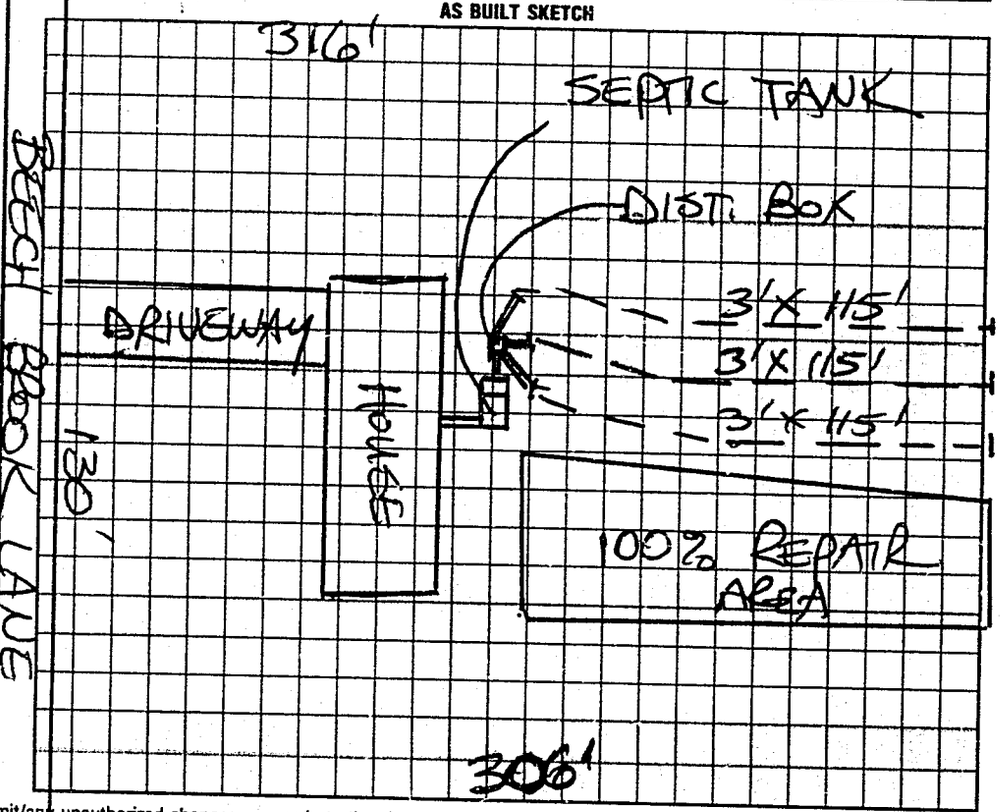

I understand that this permit can be suspended or revoked if any false information is supplied toward securing the permit/any unauthorized changes are made to the site/any unauthorized changes are made in the installation of the system. Improvement Permit is valid for 60 months from date of issuance.

Signed:

Improvement Permit by: STEVE HEDRICK date 3/21/93

Existing System Inspection by: date

Installed by: JAMES HYDER

Certificate of Completion by: STEVE HEDRICK date 6/20/94

Operation Permit by: date

HEALTH DEPT. COPY: WHITE INSPECTION COPY (FINAL): GREEN OWNER COPY (FINAL): YELLOW INSPECTION COPY (INITIAL): PINK OWNER COPY (INITIAL): GOLD