IREDELL COUNTY HEALTH DEPARTMENT - *ENVIRONMENTAL HEALTH* ☒ STATESVILLE OFFICE 704-878-5305 ☐ MOORESVILLE OFFICE 704-664-5281

IMPROVEMENT PERMIT / AUTHORIZATION TO CONSTRUCT / OPERATION PERMIT / EXISTING SYSTEM INSPECTION

PERMIT # 16901 PIN # 4725391132 DATE 10-21-11

OWNER Steve & Andrea Johnson APPLICANT: Halteras Pools PHONE: Home/Cell # 704-213-7665 Business #

SITE ADDRESS 250 Beech Brook Lane OWNER / APPLICANT ADDRESS [redacted] 250 Beech Brook Lane

SITE DIRECTIONS Hwy 90 (R) on Monticello Dr. (L) Miller Farm (L) Beech Brook

SUBDIVISION Piney Oaks BLOCK / SECTION LOT # 23 LOT AREA 1.239 Ac. DESIGN FLOW 480 L.T.A.R. .3

Septic Tank 1000 Gallons: STB 760 Date 6-[illegible]08 ☒ New System ☐ Repair ☐ Expansion System Type I II III IV V VI ☒ Residence No. Bedrooms 4 Water Supply

Pump Tank ____ Gallons: P T ____ Date ____ System Description: 25% Reduction Gravity ☐ Business No. Persons ____ ☐ Private


Pump Make ____ Model ____ Serial # ____ Repair System Description: 25% Reduction ☐ Other No. Employees ____ ☒ Public

No. Nitrification Fields: 1 No. Lines 3(1) Linear Feet 400 (133) Maintenance Agreement Required ☐ YES ☒ NO ☒ Slab ☒ Crawl Space ☐ Community


Trench Width 36" Max. Trench Bottom Depth 36" Gravel Depth n/a ☒ GRAVITY ☐ PRESSURE ☐ Basement w/plumbing ☐ Basement w/o plumbing

Comments / Conditions

INITIAL SITE SKETCH

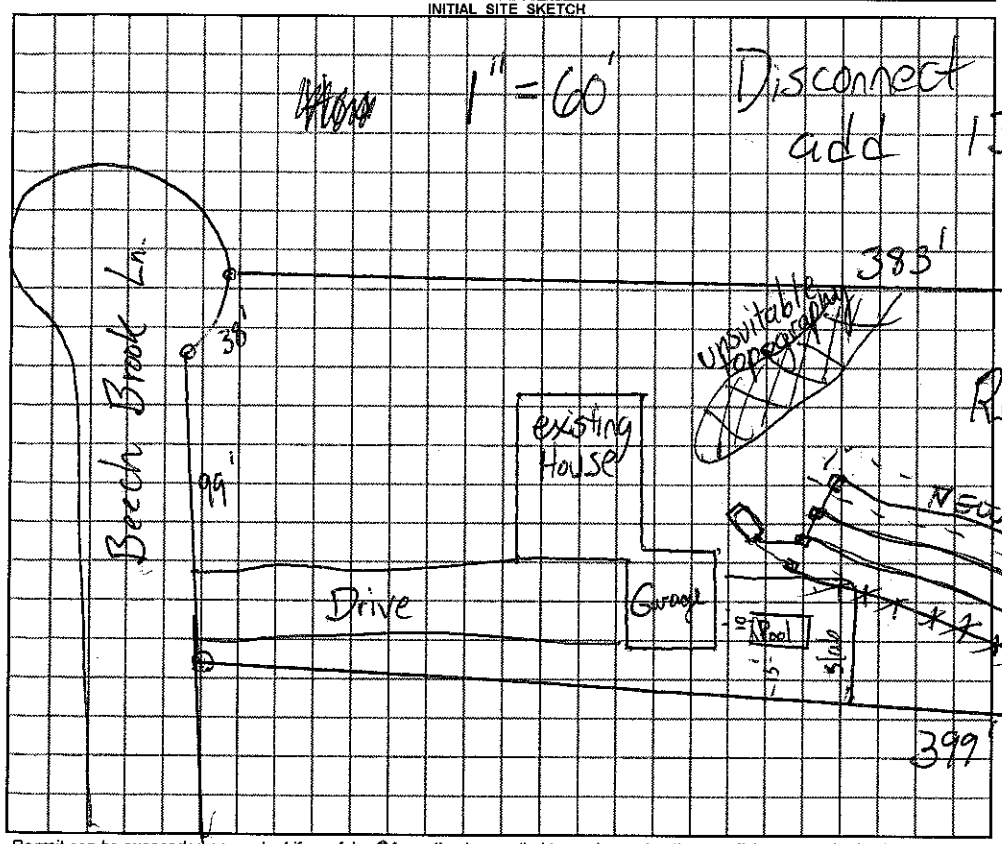

AS BUILT SKETCH

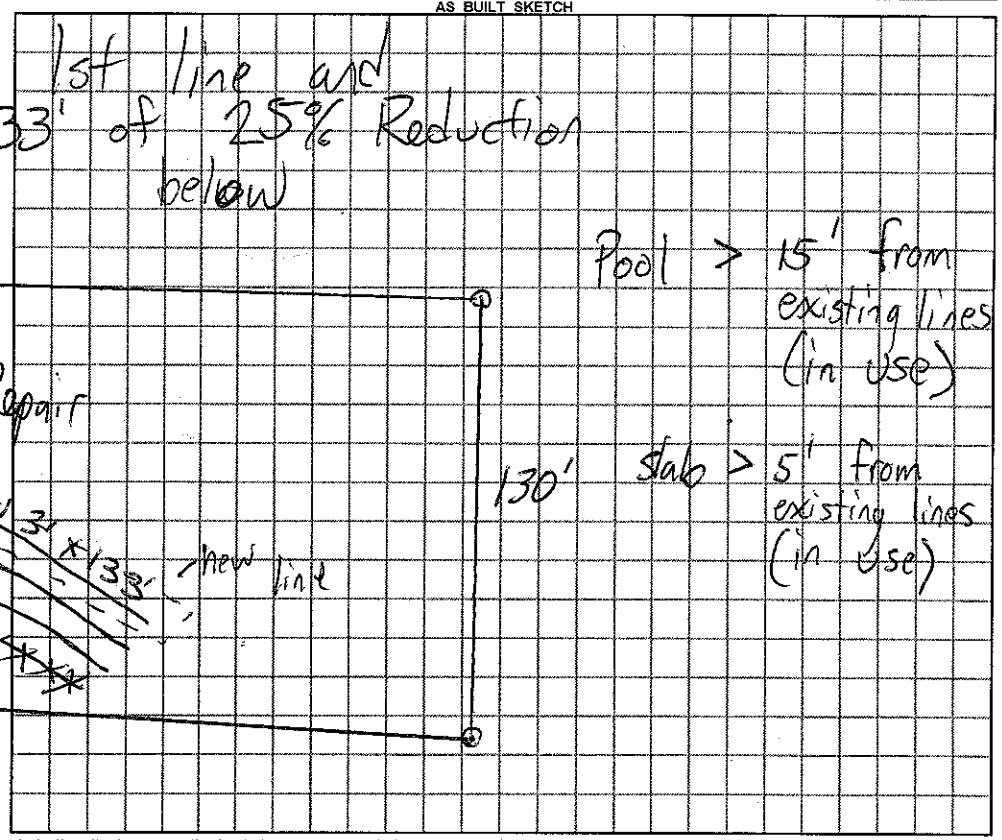

Permit can be suspended or revoked if any false information is supplied toward securing the permit / any unauthorized changes are made to the site / any unauthorized changes are made in the installation of the system.

☐ ***IMPROVEMENT PERMIT*** with plat valid without expiration. ☒ ***IMPROVEMENT PERMIT*** with ~~plat valid without expiration.~~ site plan valid 60 mo. ☒ ***AUTHORIZATION TO CONSTRUCT*** valid for period equal to IMPROVEMENT PERMIT--not to exceed 60 mo.

Owner / Applicant Signature: Donna Ballike Date 10-24 Installed by: A-1 Backhoe

IMPROVEMENT PERMIT by: [signature] ***REHS*** Date 10-21-11 OPERATION PERMIT by: [signature] ***REHS*** Date 10-24-11

AUTHORIZATION TO CONSTRUCT by: [signature] ***REHS*** Date 10-21-11 Existing System Inspected by: ***REHS*** Date

YOU SHOULD CONTACT A LOCATOR SERVICE PRIOR TO ANY EXCAVATION

White Copy – Environmental Health YELLOW COPY (Final) Owner / Applicant PINK COPY (Initial) Owner / Applicant