THIS PERMIT VOIDS PREVIOUS ISSUED 8/9/94

IREDELL COUNTY HEALTH DEPARTMENT

STATESVILLE 704-878-5305 MOORESVILLE 704-664-5281

IMPROVEMENT PERMIT / AUTHORIZATION TO CONSTRUCT / OPERATION PERMIT / EXISTING SYSTEM INSPECTION

PERMIT# 074538 PIN# 4725 39 3192 DATE 7-17-98

OWNER OR CONTRACTOR BRITTIAN P. ALEXANDER PHONE: Business Home 872-1931

ADDRESS 805 REYNOLDS ROAD, STATESVILLE, NC 28677

LOCATION NC 90W, TR MONTICELLO DRIVE, TL MILLER FARM, TL BEECHBROOK, LOT #21 ON RIGHT

SUBDIVISION PINEY OAKS BLOCK / SECTION ____ LOT 21 LOT AREA 130x 386 SITE CLASS PS DESIGN FLOW 360 L.T.A.R. 0.30 GPD/FT 2

Septic Tank: 1000 Gallons; STB 794 Date 6-22-98
Pump Tank: ____ Gallons; PT ____ Date ____
Pump Make: ____ Model ____ Serial No. ____
Nitrification Field: No Fields 1 Square Feet 1200 Linear Feet 400
No Lines FOUR Trench Width 36" Max Trench Bottom Depth 36" Gravel Depth 12"

[X] New System [ ] Repair System Type: I (II) III, IV, V, VI
System Description: CONVENTIONAL GRAVITY
Repair System Description: CONV. GRAVITY
Maintenance Agreement Required: [ ] Yes [X] No


[X] House/Mod. Home No. Bedrooms 3
[ ] Mobile Home No. Bathrooms 2½
[ ] Business No. Employees ____
[ ] Other ____
[ ] Slab [X] Crawl Space [ ] Basement w/plumbing [ ] Basement wo/plumbing

Water Supply: [ ] Individual [X] Public [ ] Community


Comments:/Conditions:

Comments:/Conditions:

INITIAL SITE SKETCH SCALE: 1"=40'

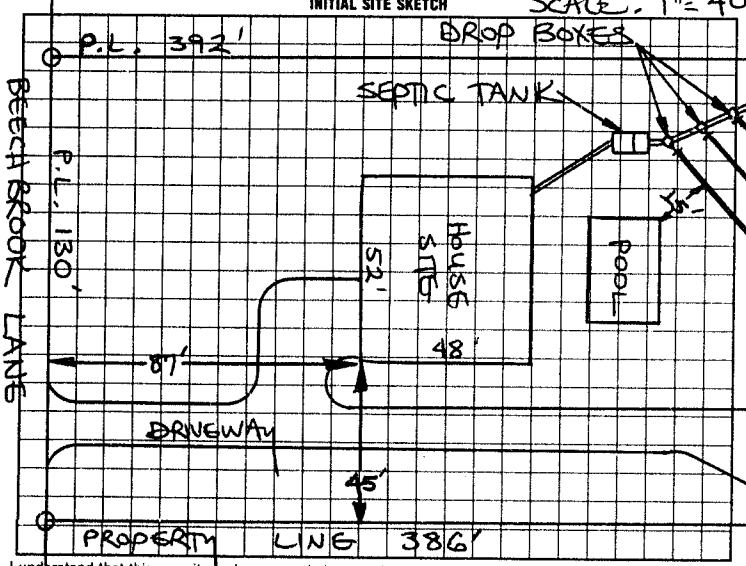

AS BUILT SKETCH

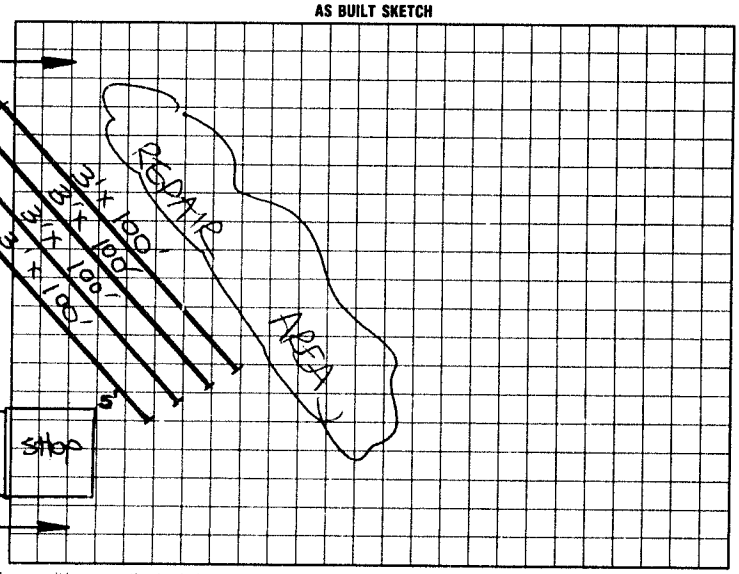

I understand that this permit can be suspended or revoked if any false information is supplied toward securing the permit/any unauthorized changes are made to the site/any unauthorized changes are made in the installation of the system. Improvement Permit with plat valid without expiration. Improvement Permit with site plan valid for sixty months. Authorization to Construct is valid for a period equal to that of Improvement Permit – not to exceed sixty months.

Signed: Brittain P. Alexander date 7-17-98 Installed by: Larry Beam

Improvement Permit by: STEVE HEDRICK date 7-17-98 Operation Permit by: [signature] RS date 2-23-99

Authorization to Construct by: STEVE HEDRICK date 7-17-98 Existing System Inspection by: ____ date ____

HEALTH DEPT. COPY: WHITE INSPECTION COPY (FINAL): GREEN OWNER COPY (FINAL): YELLOW INSPECTION COPY (INITIAL): PINK OWNER COPY (INITIAL): GOLD