45

IREDELL COUNTY HEALTH DEPARTMENT

Statesville Office (704) 878-5305 Mooresville Office (704) 660-3625 PERMIT # 215186

IMPROVEMENT PERMIT / AUTHORIZATION TO CONSTRUCT / OPERATION PERMIT / EXISTING SYSTEM

PIN # 4725-39-7193.000 V

APPLICANT: Chris McHargue (McHargue Home Solution) APPLICANT ADDRESS: 468 Lentz Rd. Statesville NC 28625

SITE ADDRESS: 220 Beech Brook Ln. Statesville NC PHONE: 704-902-1845 ALT. PHONE: 704-881-2975

SITE DIRECTIONS: I-77 N TL Old Wilkesboro, TL Bradley Farm, TL Monticello Rd, TR Miller Farm, TL Beech Brook


SUBDIVISION: Piney Oaks SECTION: — LOT # 18 LOT AREA: 1.100 Acre DESIGN FLOW: 360 GPD L.T.A.R.: .3

Septic Tank	1000	(gal)	STB	760	Date	12-21-15	☐ New System ☐ Repair ☐ Expansion	System Type: I II (III) IV V VI	☒ Residence	No. Bedrooms	3	Water Supply
Pump Tank	N/A	(gal)	PT	N/A	Date	N/A	System Description:	25% Reduction - Gravity	☐ Business	No. Persons	6	☐ Private
Pump Make	N/A	Model		Polylok	Serial #	PL-68	Repair System Description:	25% Reduction - Gravity	☐ Other	No. Employees		☒ Public
# Nitrification Fields	1	# Lines		1	Linear Ft:	39'	Maintenance Agreement Required:	☐ YES ☒ NO	☐ Slab	☐ Crawl Space		☐ Community
Trench Width	36"	Max. Trench Bottom Depth		36"	Gravel Depth	N/A	☐ GRAVITY	☐ PRESSURE	☐ Basement w/plumbing		☐ Basement w/o plumbing	

Comments / Conditions: Crush & Fill Existing Septic Tank. Remove And/or Earth & Dam 50' of Existing 1st Line To Make 10' Separation From Proposed Sun Room. Install New Tank Where Shown And 5' From Existing Shed.


10' From Any Crawl Space Structure. Install 39' of 25% Reduction Recon Last Line In Serial Distribution. Any Existing Structures/Sheds Must Be 5'

INITIAL SITE SKETCH

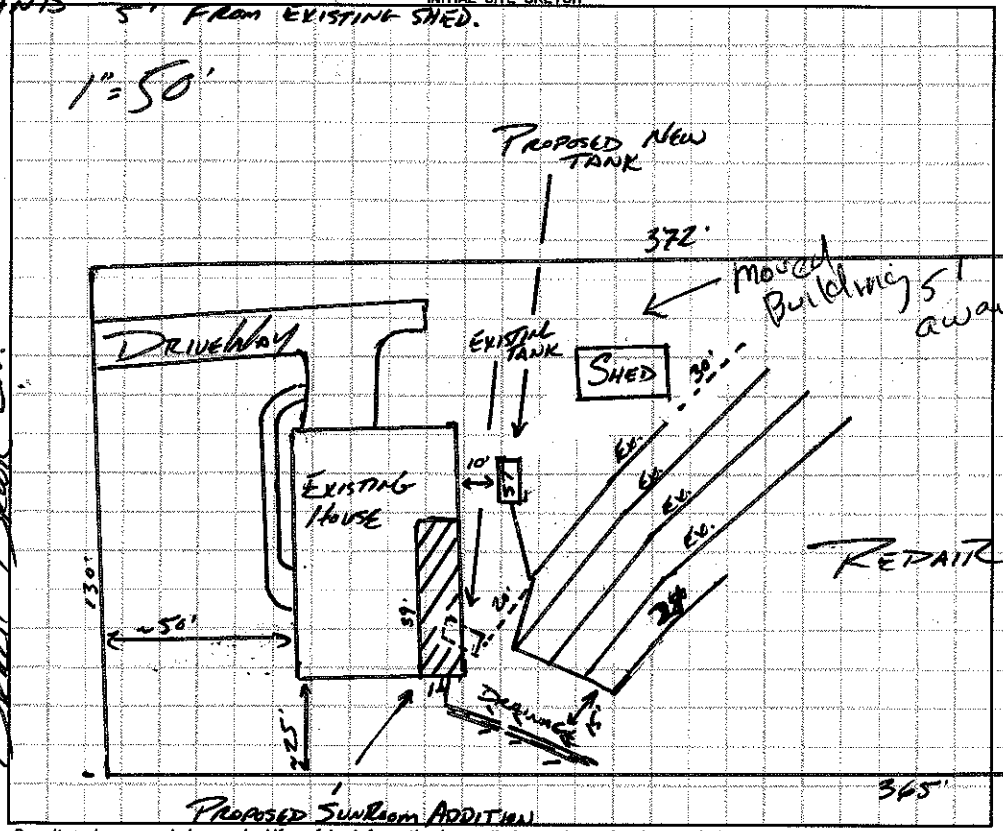

AS BUILT SKETCH

From Existing Drainfield @ Time of Inspection. Keep Any Drainage 15' Side Slope From Drainfield.

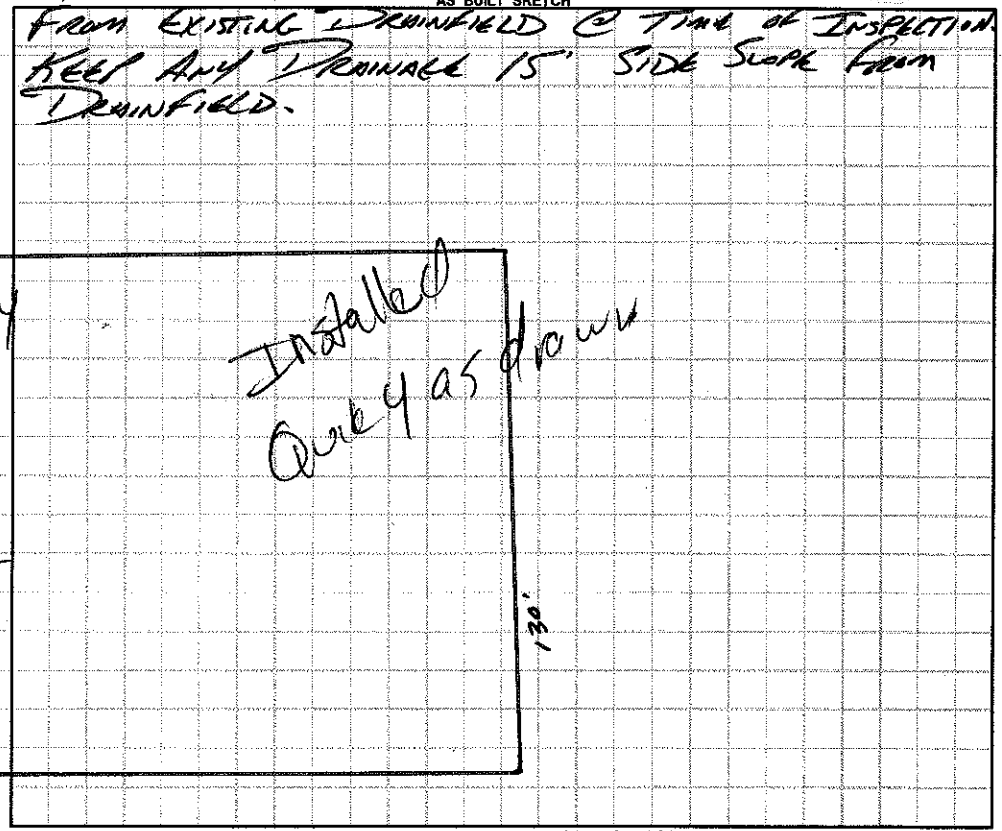

Permit can be suspended or revoked if any false information is supplied toward securing the permit / any unauthorized changes are made to the site / any unauthorized changes are made in the installation of the system. **CONTACT A LOCATOR SERVICE PRIOR TO ANY EXCAVATION**

☐ **IMPROVEMENT PERMIT** *with plat valid without expiration.* ☒ **IMPROVEMENT PERMIT** *with site plan valid for 60 mos.* ☒ **AUTHORIZATION TO CONSTRUCT** *valid for period equal to IMPROVEMENT PERMIT--not to exceed 60 mo.*

Owner / Applicant Signature: [signature] Date: 1-29-16 Installed by: Lentz Wastewater

IMPROVEMENT PERMIT by: [signature] APPROVED: JAN 21 2016 OPERATION PERMIT by: [signature] Date: 02/09/16

AUTHORIZATION TO CONSTRUCT by: [signature] APPROVED JAN 21 2016 Existing System Inspected by: Date:

Health Dept. Copy - WHITE Applicant (Final Approval) - YELLOW Applicant (Conditional Approval) - PINK