IREDELL COUNTY HEALTH DEPARTMENT

STATESVILLE 704-878-5305 MOORESVILLE 704-664-5281

IMPROVEMENT PERMIT / CERTIFICATE OF COMPLETION / OPERATION PERMIT / EXISTING SYSTEM INSPECTION

PROPERTY DESCRIPTION NO. 0688660 DATE 8-25-97 TAX MAP NO. 4725 39 7193 Watershed: ☐ Yes ☒ No

OWNER OR CONTRACTOR MICHAEL LEVAN PHONE: Business Home 876-2709

ADDRESS 3020 WILKESBORO ROAD, STATESVILLE, NC 28677

LOCATION NC 115 N, TL SCOTTS CREEK, TL MILLER FARM, TR BEECH BROOK, LOT ON (R) ACROSS FROM #321

SUBDIVISION PINEY OAKS BLOCK / SECTION ____ LOT 18 LOT AREA 1.0 ACRE SITE CLASS. PS DESIGN FLOW 360 L.T.A.R. 0.30 GPD/FT²

Septic Tank: 1000 Gallons; STB 794 Date ~~7-95~~

Pump Tank: ____ Gallons; PT ____ Date 3-30-98

Pump Make: ____ Model ____ Serial No. ____

Nitrification Field: No Fields 1 Square Feet 1200 Linear Feet 400

No Lines FOUR Trench Width 36" Max Trench Bottom Depth 36" Gravel Depth 12"

☒ New System ☐ Repair System Type: I, II, III, IV, V, VI

System Description: CONVENTIONAL GRAVITY

Repair System Description: CONV. GRAVITY

Maintenance Agreement Required: ☐ Yes ☒ No

☒ House/Mod. Home No. Bedrooms 3

☐ Mobile Home No. Bathrooms 2

☐ Business No. Employees ____

☐ Other ____

☐ Slab ☒ Crawl Space ☐ Basement w/plumbing ☐ Basement wo/plumbing


Water Supply: ☐ Individual ☐ Community ☒ Public

Comments:


Comments:

* Driveway switched to opposite side

INITIAL SITE SKETCH SCALE: 1" = 60'

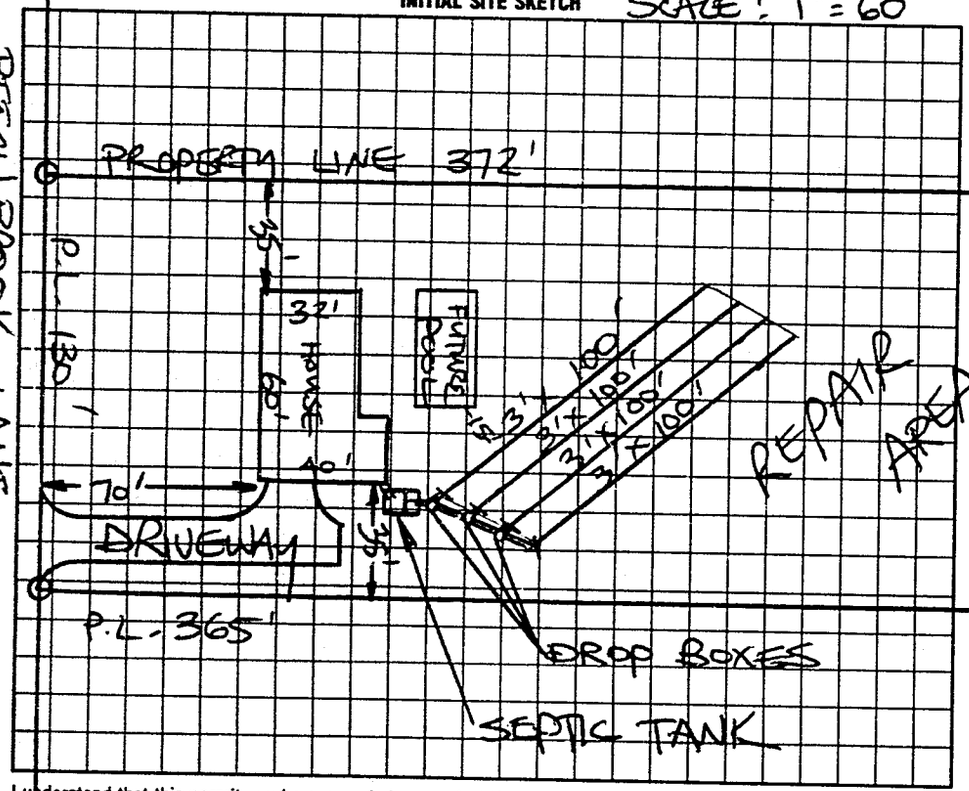

AS BUILT SKETCH

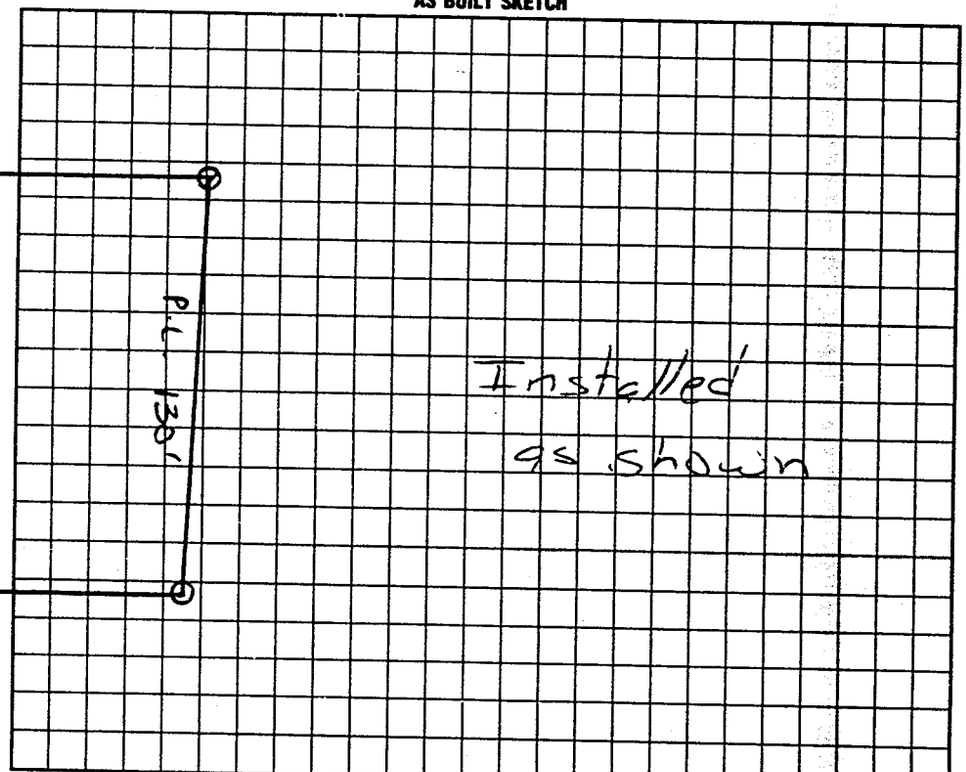

I understand that this permit can be suspended or revoked if any false information is supplied toward securing the permit/any unauthorized changes are made to the site/any unauthorized changes are made in the installation of the system. Improvement Permit is valid for ~~60 months~~ from date of issuance. AUTHORIZATION TO CONSTRUCT IS VALID FOR 60 MONTHS FROM DATE OF ISSUANCE.

Signed: [signature]

Improvement Permit by: STEVE HEDRICK date 8-25-97

AUTH. TO CONST. ~~Existing System Inspection~~ by: STEVE HEDRICK date 8-25-97

Installed by: James Hudler

~~Certificate of Completion by:~~ ____ date ____

Operation Permit by: [signature] date 6-18-98

HEALTH DEPT. COPY: WHITE INSPECTION COPY (FINAL): GREEN OWNER COPY (FINAL): YELLOW INSPECTION COPY (INITIAL): PINK OWNER COPY (INITIAL): GOLD