IREDELL COUNTY HEALTH DEPARTMENT

Statesville Phone TR 3-7271 — Mooresville Phone NO 3-1271

PERMIT TO INSTALL SEPTIC TANK

Permit NO. _____ Permit Date Nov 3- 1960

Owner McKinney apts. - Address Iff Hwy 21 R.D.

Installed By C Hoke Address R7.

Location of Property out 90 past By Pass 1st pave to left 2nd on R 1 block off Rd.


Tank		Capacity		Length of Lines		Fixtures	
Block	( )	800	( )	150'	( )	No. of Baths	( )
Precast	( )	900	( )	175'	( )	Dishwasher	( )
		1000	( )	200'	( )	Garbage Grdr.	( )
		1100	( )	225'	( )	Auto-Washer	( )
		1200	( )	250'	( )	Other	
		Other		Other 400 ft.			

NOTIFY HEALTH DEPARTMENT AT LEAST EIGHT HOURS BEFORE TANK IS TO BE INSPECTED.

Final Inspection 11-3 1960 Approved (✓) Disapproved ( )

Remarks lines only - owner built own tanks

well 50'

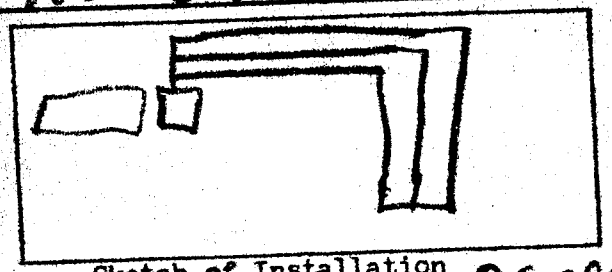

Sketch of Installation O Well

APT

Self app

Sanitarian