IREDELL COUNTY HEALTH DEPARTMENT

STATESVILLE 704-878-5305 ✓ MOORESVILLE 704-664-5281

IMPROVEMENT PERMIT / AUTHORIZATION TO CONSTRUCT / OPERATION PERMIT / EXISTING SYSTEM INSPECTION

PERMIT# 102,355 PIN# 4725-41-4093

OWNER OR CONTRACTOR BellSouth TeleComm. / Skidmore Builder PHONE: Business (704) 545-7059 Home Skidmore (704) 525-4676 DATE 10/4/01

ADDRESS 11120 Red Grouse Lane Charlotte, NC, 28227

LOCATION I-40W, Hwy 90 East

SUBDIVISION — BLOCK / SECTION — LOT — LOT AREA 4.2 Acres SITE CLASS PS DESIGN FLOW 150 L.T.A.R. .50 gal/ft²

Septic Tank: 4000 Gallons: STB 1012 Date 7-22-01
Pump Tank: ____ Gallons; PT ____ Date ____
Pump Make: ____ Model ____ Serial No. ____
Nitrification Field: No. Fields 1 Square Feet 300 Linear Feet 100
No. Lines 20 50ft Trench Width 36" Max Trench Bottom Depth 30" Gravel Depth 12"

X New System ☐ Repair System Type: I (II) III IV V VI
System Description: Gravity, Conventional
Repair System Description: Gravity, Conventional
Maintenance Agreement Required: ☐ Yes ☐ No

☐ House/Mod. Home No. Bedrooms ____
☐ Mobile Home No. Bathrooms ____
X Business No. Employees 6
☐ Other [redacted]

☐ Slab X Crawl Space ☐ Basement w/plumbing ☐ Basement wo/plumbing


Water Supply: ☐ Individual ☐ Public ☐ Community

Comments/Conditions: ① Remove all compacted gravel ② Install trench line with minimum 12" cover then 12" gravel ③ Maintain Proper Setbacks keep 5'off Hy foundation, 15'off bank etc.


Comments/Conditions: - Septa Tank marker Installed - PVC fork fittings Installed

(Not to Scale)

INITIAL SITE SKETCH

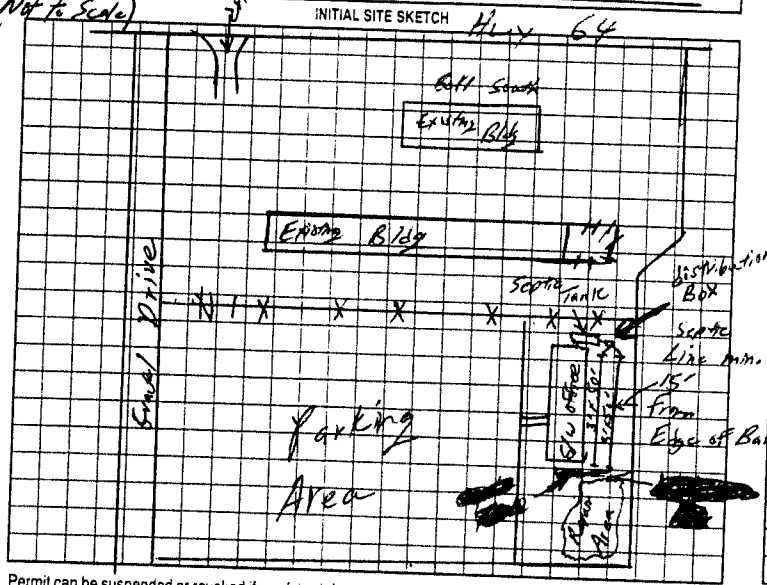

AS BUILT SKETCH

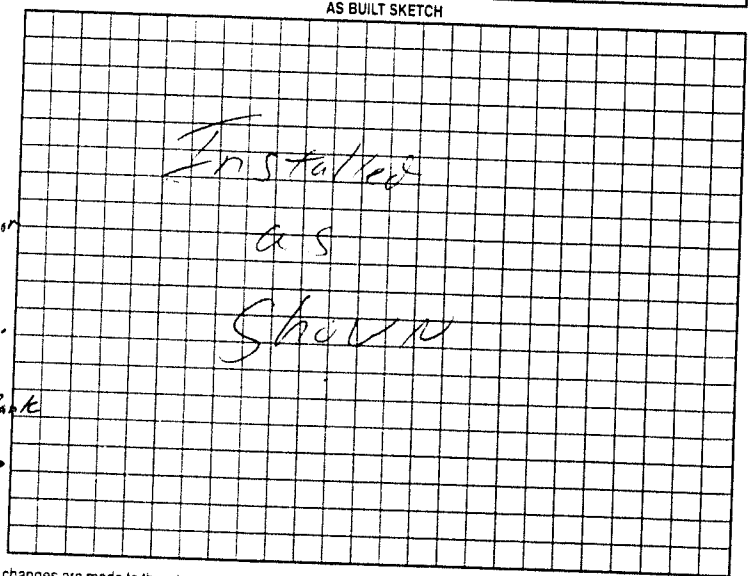

Permit can be suspended or revoked if any false information is supplied toward securing the permit/any unauthorized changes are made to the site/any unauthorized changes are made in the installation of the system. Improvement Permit with plat valid without expiration. Improvement Permit with site plan valid for sixty months. Authorization to Construct is valid for a period equal to that of Improvement Permit – not to exceed sixty months.

Signed: Tom Skidmore date 10/4/01

Improvement Permit by: William G Johnson date 10/4/01

Authorization to Construct by: William G Johnson date 10/4/01

Installed by: A-1 Backhoe

Operation Permit by: William G Johnson date 10/19/01

Existing System Inspection by: ____ date ____

HEALTH DEPT. COPY: WHITE OWNER COPY (FINAL): YELLOW OWNER COPY (INITIAL): PINK