# IREDELL COUNTY HEALTH DEPARTMENT

STATESVILLE 704-878-5305 CJ MOORESVILLE 704-664-5281

## IMPROVEMENT PERMIT / AUTHORIZATION TO CONSTRUCT / OPERATION PERMIT / EXISTING SYSTEM INSPECTION

PERMIT# 117745 PIN# 4725-48-0765 DATE 1-20-04

OWNER OR CONTRACTOR TERRY O'BRIEN PHONE: Business 704-876-8600 Home

ADDRESS 310 TREE BARK ROAD, STATESVILLE, NC 28625

LOCATION NC 115 N, TL SCOTTS CREEK RD, TL MILLER FARM RD, TR BEECH BROOK LANE, ON LEFT 8TH BEFORE END

SUBDIVISION PINEY OAKS BLOCK / SECTION LOT 33 LOT AREA 1.05 ACRE SITE CLASS. PS DESIGN FLOW 360 L.T.A.R. 0.30 GPD/FT²

Septic Tank: 1000 Gallons; STB 1007 Date

Pump Tank: Gallons; PT Date

Pump Make: Model Serial No.

Nitrification Field: No Fields 1 Square Feet 1200 Linear Feet 300

No Lines SIX Trench Width 36" Max Trench Bottom Depth 36"

☑ New System ☐ Repair System Type: I, II, III, IV, V, VI

System Description: 25% REDUCTION, GRAVITY

Repair System Description: 50% REDUCTION (ON PRESSURE)

Maintenance Agreement Required: ☐ Yes ☑ No

☑ House/Mod. Home ☐ Mobile Home ☐ Business ☐ Other

No. Bedrooms 3 No. Bathrooms 2 No. Employees


☐ Slab ☑ Crawl Space ☐ Basement w/plumbing ☐ Basement wo/plumbing

Water Supply: ☐ Individual ☑ Public ☐ Community


Comments:/Conditions: INSTALL 25% REDUCTION SYSTEM ON CONTOUR AS SHOWN. STUB-OUT SHALLOW TO ACCOMODATE 36" TRENCH DEPTH TO AVOID PUMP-SYSTEM

Comments:/Conditions:
- Red Poly Ick Filter & ST marker Installed
- 48 Inspection Chamber Installed

INITIAL SITE SKETCH

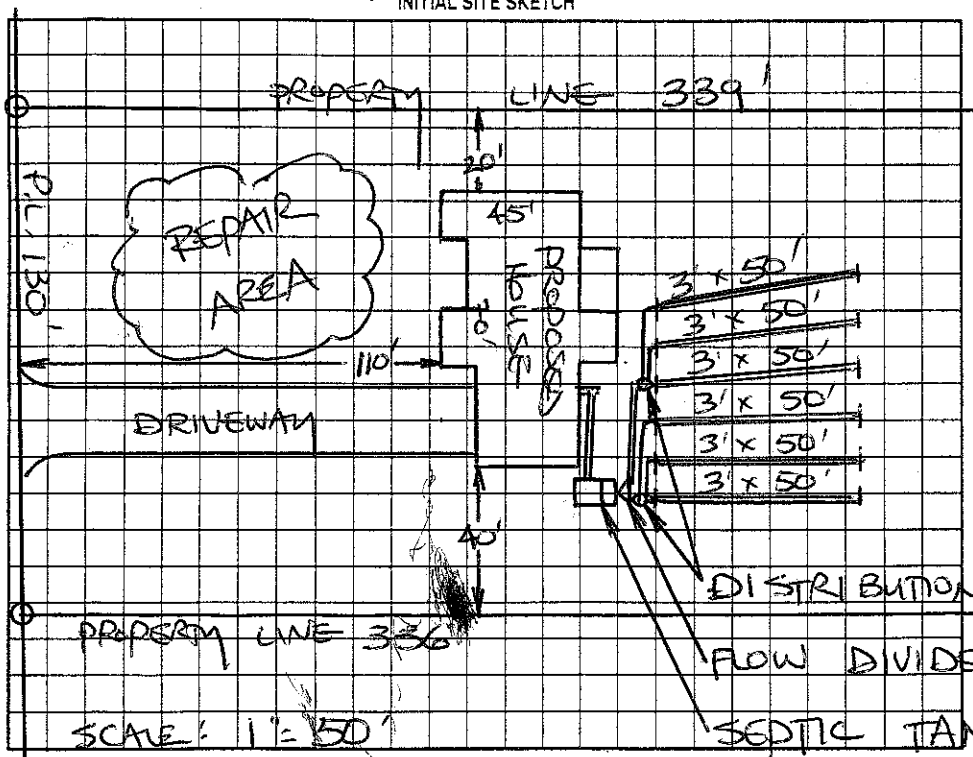


AS BUILT SKETCH

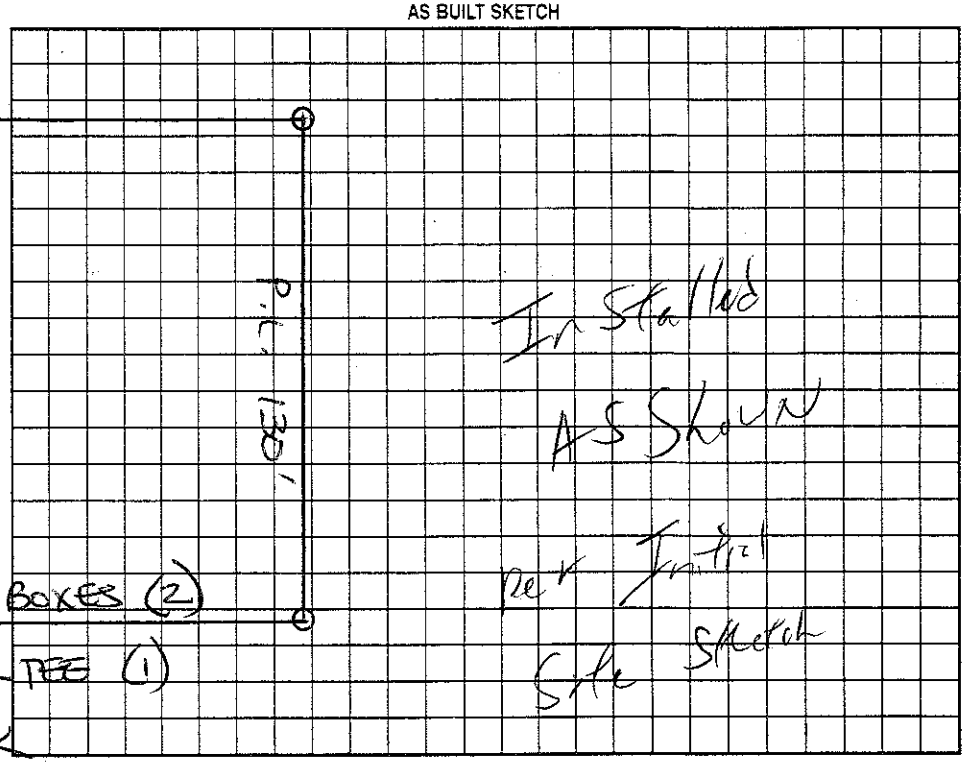


Permit can be suspended or revoked if any false information is supplied toward securing the permit/any unauthorized changes are made to the site/any unauthorized changes are made in the installation of the system. Improvement Permit with plat valid without expiration. Improvement Permit with site plan valid for sixty months. Authorization to Construct is valid for a period equal to that of Improvement Permit – not to exceed sixty months.

Signed: date 1-21-04

Improvement Permit by: STEVE HEDRICK date 1-20-04

Authorization to Construct by: STEVE HEDRICK date 1-20-04

Installed by: Bill Greene

Operation Permit by: William O. Johnson date 6/29/04

Existing System Inspection by: date

HEALTH DEPT. COPY: WHITE OWNER COPY (FINAL): YELLOW OWNER COPY (INITIAL): PINK