IREDELL COUNTY HEALTH DEPARTMENT

STATESVILLE 704-878-5305 MOORESVILLE 704-664-5281

IMPROVEMENT PERMIT / AUTHORIZATION TO CONSTRUCT / OPERATION PERMIT / EXISTING SYSTEM INSPECTION

PERMIT # 158161 PIN # 4725-49-1185 DATE 13 October 09

OWNER or APPLICANT Mark A. Crouse PHONE: ~~Business~~ cell (704) 500-1495 ~~Home~~ (704) 873-0466

OWNER or APPLICANT ADDRESS 200 Beech Brook Lane Statesville, N.C.

LOCATION / DIRECTIONS Scotts Creek Rd. TL Miller Farm Rd. TR Beech Brook Ln. House near end on Rt.

SUBDIVISION Piney Oaks BLOCK / SECTION LOT # 15 LOT AREA DESIGN FLOW 360 g/d L.T.A.R. 0.3

Septic Tank Existing Gallons: STB Date

Pump Tank Gallons: P T Date

Pump Make Model Serial #

Nitrification Field No Fields 1 No Lines 1 Linear Feet 40'

Trench Width 36" Max. Trench Bottom Depth 36" Gravel Depth NA

☐ New System ☐ Repair ☑ Expansion System Type I II (III) IV V VI

System Description: 25% Reduction

Repair System Description: 50% Reduction

Maintenance Agreement Required ☐ YES ☑ NO

☑ GRAVITY ☐ PRESSURE

☐ Residence No. Bedrooms 3

☐ Business No. Persons

☑ Other No. Employees

☐ Slab ☐ Crawl Space


☑ Basement w/plumbing ☐ Basement w/o plumbing

Water Supply: ☐ Private ☑ Public ☐ Community


Comments / Conditions: Adding 24x40 Garage - no plumbing / Existing Pool encroachment onto existing septic system / New Portion of 1 nitrification line will have to be Abandoned w/ replacement in suitable Area.

Comments / Conditions

INITIAL SITE SKETCH

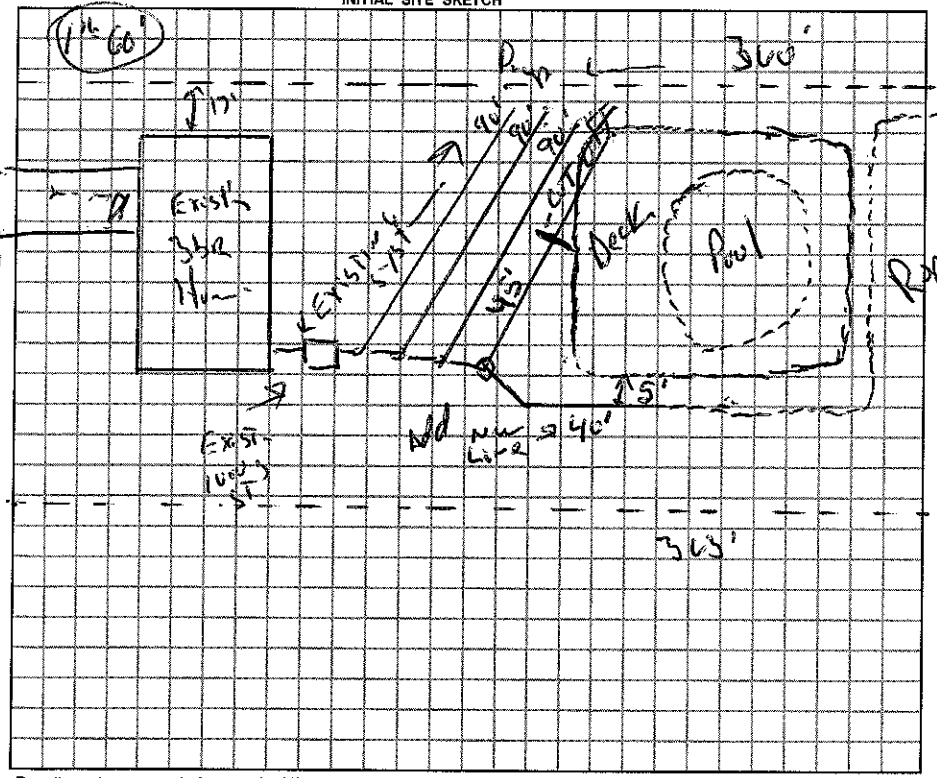

AS BUILT SKETCH

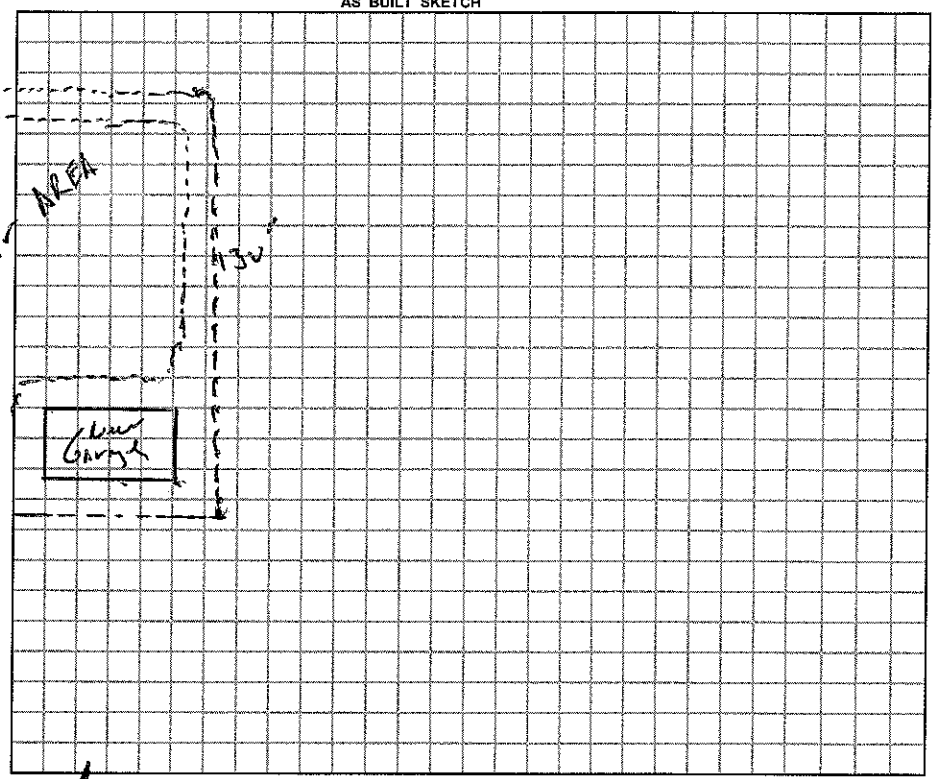

Permit can be suspended or revoked if any false information is supplied toward securing the permit / any unauthorized changes are made to the site / any unauthorized changes are made in the installation of the system.

☐ *IMPROVEMENT PERMIT w / plat valid without expiration.* ☐ *IMPROVEMENT PERMIT w / site plan valid for 60 mos.* ☑ *AUTHORIZATION TO CONSTRUCT valid for period equal to IMPROVEMENT PERMIT-not to exceed 60 mo.*

Owner / Applicant Signature: Mark A Crouse Date 10-13-09

Improvement Permit by: R.S. Date 13 Oct. 09

Authorization to Construct by: R.S. Date 13 October 09

Installed by: Groundbreakers

Operation Permit by: Date: 10-30-09

Existing System Inspected by: Date:

YOU SHOULD CONTACT A LOCATOR SERVICE PRIOR TO ANY EXCAVATION.

WHITE COPY Environmental Health YELLOW COPY (Final) Owner / Applicant PINK COPY (Initial) Owner / Applicant