055514

IREDELL COUNTY HEALTH DEPARTMENT

STATESVILLE 704-878-5305 MOORESVILLE 704-664-5281

IMPROVEMENT PERMIT / CERTIFICATE OF COMPLETION / OPERATION PERMIT / EXISTING SYSTEM INSPECTION

PROPERTY DESCRIPTION NO. 20813 DATE 4/7/95 TAX MAP NO. 9D-13-A-14 Watershed: ☐ Yes ☑ No

OWNER OR CONTRACTOR MIKE GAITHER PHONE: Business Home 871-7295

ADDRESS 184 SERENITY DR, MOCKSVILLE NC 27028

LOCATION NC 90 W, TR MONTICELLO DR, TL MILLER FARM RD, TL BEECHBROOK LANE, LOT on (R)

SUBDIVISION PINEY OAKS BLOCK / SECTION LOT 14 LOT AREA 130X365 SITE CLASS. P3 DESIGN FLOW 360 L.T.A.R. 0.30 GPD/FT²

Septic Tank: 1000 Gallons; STB 1012 Date 2-15-96

Pump Tank: Gallons; PT Date

Pump Make: Model Serial No.

Nitrification Field: No Fields 1 Square Feet 1200 Linear Feet 400

No Lines 3 Trench Width 36" Max Trench Bottom Depth 18-36 Gravel Depth 12"

☑ New System ☐ Repair System Type: I, II, III, IV, V, VI

System Description: CONVENTIONAL GRAVITY

Repair System Description: CONV. GRAVITY

Maintenance Agreement Required: ☐ Yes ☑ No

☑ House/Mod. Home No. Bedrooms 3

☐ Mobile Home No. Bathrooms 2

☐ Business No. Employees

☐ Other

☐ Slab ☐ Crawl Space ☐ Basement w/plumbing ☑ Basement wo/plumbing


Water Supply: ☐ Individual ☐ Community ☑ Public

Comments:

KEEP SYSTEM MINIMUM 10' FROM BASMENT FOUNDATION DRAIN

Comments:

INITIAL SITE SKETCH

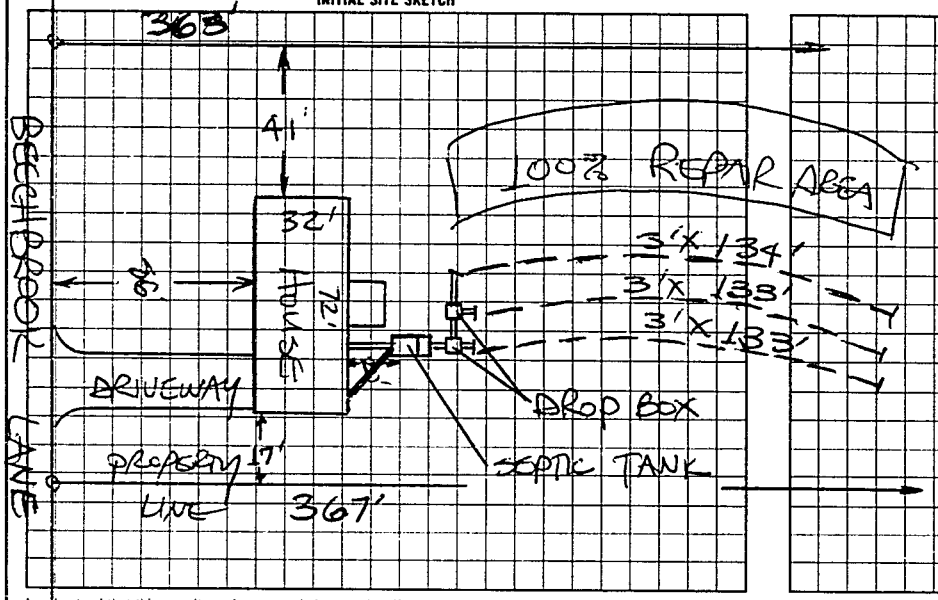

AS BUILT SKETCH

SYSTEM INSTALLED ACCORDING TO INITIAL SITE SKETCH

I understand that this permit can be suspended or revoked if any false information is supplied toward securing the permit/any unauthorized changes are made to the site/any unauthorized changes are made in the installation of the system. Improvement Permit is valid for 60 months from date of issuance.

Signed: X Mike Gaither

Improvement Permit by: STEVE HEDRICK date 4/7/95

Existing System Inspection by: date

Installed by: DAVID YOUNTZ

Certificate of Completion by: date

Operation Permit by: STEVE HEDRICK date 4-11-96

HEALTH DEPT. COPY: WHITE INSPECTION COPY (FINAL): GREEN OWNER COPY (FINAL): YELLOW INSPECTION COPY (INITIAL): PINK OWNER COPY (INITIAL): GOLD

2 2 0 0 0