ALEX Co. RUSSELL

IREDELL COUNTY HEALTH DEPARTMENT

Statesville Phone TR 3-7271 Mooresville Phone NO 3-1271

PERMIT TO INSTALL SEPTIC TANK

Permit NO. ~~Patton Bldg~~ Wilson Elder Permit Date Aug 31 19 62

Owner ~~Patton Bldg~~ Warehouse Address Tayls Rd

Installed By C T & K Address R 2


Location of Property ON Right beyound Dixie Liberty ON 90 W.

Tank		Capacity		Length of Lines		Fixtures	
Block	( )	800	( )	150'	( )	No. of Baths	(1)
Precast	(✓)	900	( )	175'	( )	Dishwasher	( )
		1000	(✓)	200'	( )	Garbage Grdr.	( )
		1100	( )	225'	(✓)	Auto-Washer	( )
		1200	( )	250'	( )	Other	
		Other		Other			

NOTIFY HEALTH DEPARTMENT AT LEAST EIGHT HOURS BEFORE TANK IS TO BE INSPECTED.

Final Inspection 9-3 1962 Approved (✓) Disapproved ( )

Remarks Very NARROW lot · city WATER

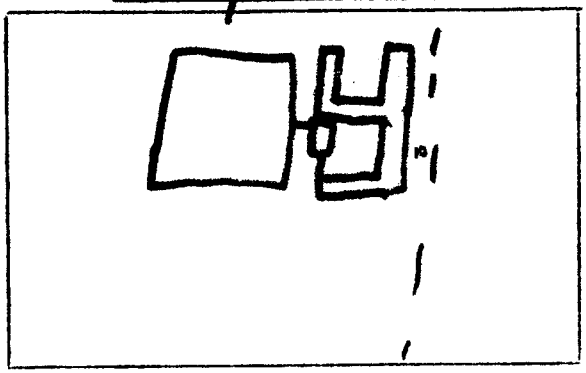

Sketch of Installation

Sanitarian