IREDELL COUNTY HEALTH DEPARTMENT

Statesville Phone TR 3-7271 Mooresville Phone NO 3-1271

PERMIT TO INSTALL SEPTIC TANK

Permit NO. _____ Permit Date 10-24 1969

Owner Sinclair Service Station Address Statesville, NC

Installed By Ladd Harry Setzer Address Charlotte N C


Location of Property Intersection I 40 & Hwy 90 W. on Rt.

Tank		Capacity		Length of Lines		Fixtures	
Block	( )	1000	(✓)	225'	( )	No. of Baths	( )
Precast	( )	1250	( )	250'	( )	Dishwasher	( )
		1500	( )	Other Disposal 8' x 120'		Garbage Grdr.	( )
		Other _____				Other _____	

NOTIFY HEALTH DEPARTMENT AT LEAST EIGHT HOURS BEFORE TANK IS TO BE INSPECTED.

Final Inspection 10-24 1969 Approved (✓) Disapproved ( )

Remarks City water

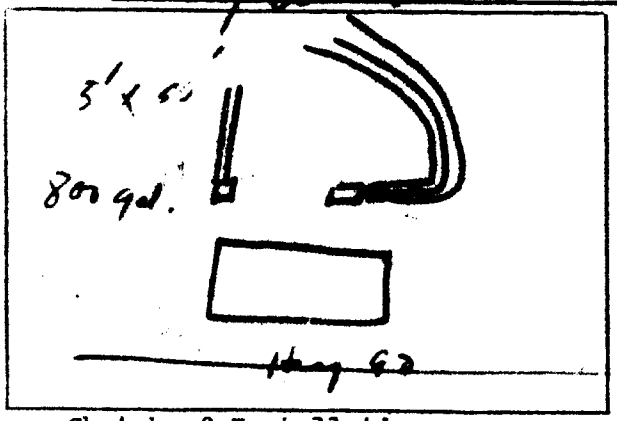

Sketch of Installation

Sanitarian