# IREDELL COUNTY HEALTH DEPARTMENT

STATESVILLE 704-878-5305 MOORESVILLE 704-664-5281

## IMPROVEMENT PERMIT / AUTHORIZATION TO CONSTRUCT / OPERATION PERMIT / EXISTING SYSTEM INSPECTION

PERMIT# 132318 PIN# 4725535569 DATE 12-1-05

OWNER OR CONTRACTOR Built Rite PHONE: Business 704-201-9935 Home

ADDRESS 215 Treebark RD Statesville NC

LOCATION I-40W (ER) 62 90 - (ER) 90 (ER) Monticello RD (ER) Whisper Pine RD 2nd lot on left

SUBDIVISION KF Steele BLOCK / SECTION LOT 1 LOT AREA 1.5 SITE CLASS. B DESIGN FLOW 360 L.T.A.R. 1.3

Septic Tank: 1000 Gallons; STB 525 Date

Pump Tank: Gallons; PT Date

Pump Make: Model Serial No.

Nitrification Field: No Fields Square Feet 1200 Linear Feet 360

No Lines 5 Trench Width 36" Max Trench Bottom Depth 36" Gravel Depth N/A

☑ New System ☐ Repair System Type: I, II, III, IV, V, VI

System Description: 25% Gravel

Repair System Description: 25% Gravel

Maintenance Agreement Required: ☐ Yes ☐ No

☑ House/Mod. Home No. Bedrooms 3

☐ Mobile Home No. Bathrooms

☐ Business No. Employees

☐ Other


☐ Slab ☑ Crawl Space ☐ Basement w/plumbing ☐ Basement wo/plumbing

Water Supply: ☐ Individual ☑ Public ☐ Community

Comments:/Conditions: Install on Contour Maintain all setbacks

Comments:/Conditions: Blue Lustite filter Septic tank inspected 5 lines @ 60 each. 25% Red

INITIAL SITE SKETCH

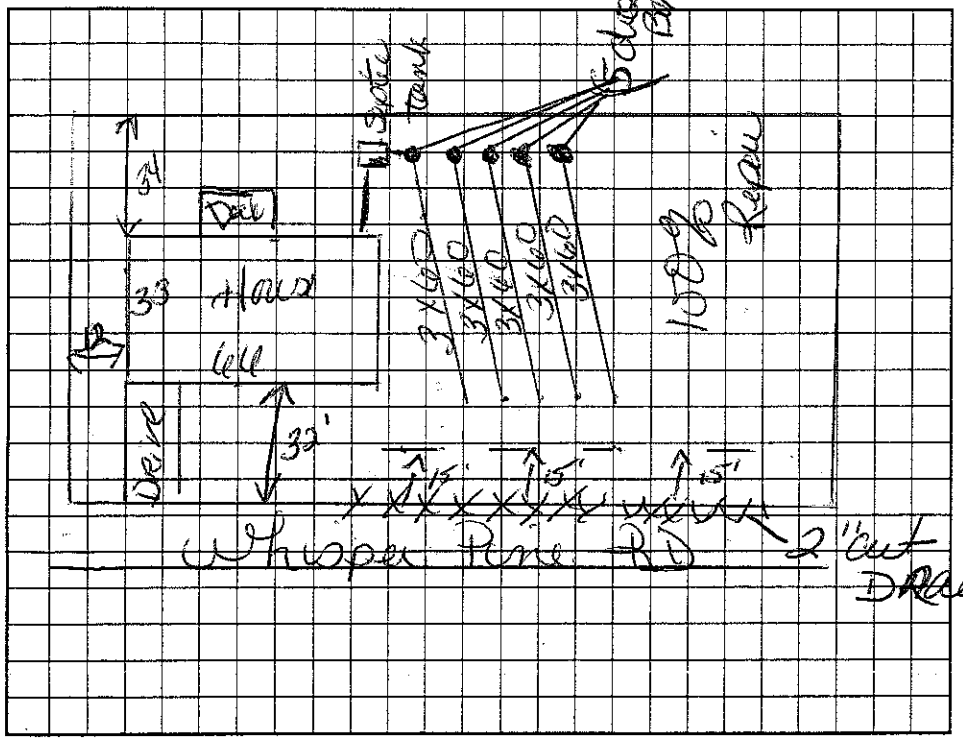


AS BUILT SKETCH

Permit can be suspended or revoked if any false information is supplied toward securing the permit/any unauthorized changes are made to the site/any unauthorized changes are made in the installation of the system. Improvement Permit with plat valid without expiration. Improvement Permit with site plan valid for sixty months. Authorization to Construct is valid for a period equal to that of Improvement Permit – not to exceed sixty months.

Signed: date Installed by: Madison

Improvement Permit by: Kelley Cook date 12-1-05 Operation Permit by: Kelley Cook date 2-7-06

Authorization to Construct by: Kelley Cook date 12-1-05 Existing System Inspection by: date

HEALTH DEPT. COPY: WHITE OWNER COPY (FINAL): YELLOW OWNER COPY (INITIAL): PINK