IREDELL COUNTY HEALTH DEPARTMENT

STATESVILLE 704-878-5305 MOORESVILLE 704-664-5281

IMPROVEMENT PERMIT / AUTHORIZATION TO CONSTRUCT / OPERATION PERMIT / EXISTING SYSTEM INSPECTION

PERMIT# REPAIR PIN# 4725-53-6950 DATE 11-16-07

OWNER OR APPLICANT JOHN EDWARD OGLESBY PHONE: Business 704-682-5173 Home

ADDRESS 349 MONTICELLO DRIVE, STATESVILLE NC 28625-2329

LOCATION NC 90 WEST, TR MONTICELLO DRIVE, 2ND HOUSE ON RIGHT PAST WHISPER PINE ROAD

SUBDIVISION BLOCK / SECTION LOT LOT AREA 2.37 ACRES SITE CLASS. PS DESIGN FLOW 600 L.T.A.R. 0.30 GPD/FT2

Septic Tank EXISTING Gallons; STB Date

Pump Tank: Gallons; PT Date

Pump Make: Model Serial No.

Nitrification Field: No Fields 1 Square Feet 1080 Linear Feet 270

No Lines THREE Trench Width 36" Max Trench Bottom Depth 36" Gravel Depth N/A

☒ ~~New System~~ ☒ Repair ☐ Expansion System Type: I II III IV V VI

System Description:

Repair System Description: 25% REDUCTION, GRAVITY

Maintenance Agreement Required: ☐ Yes ☒ No

☒ House/Mod. Home ☐ Mobile Home ☐ Business ☐ Other

No. Bedrooms 5 No. Persons No. Employees


Water Supply: ☐ Individual ☒ Public ☐ Community

☒ Gravity ☐ Pressure ☐ Slab ☒ Crawl Space ☐ Basement w/plumbing ☐ Basement wo/plumbing


Comments:/Conditions: ① INSTALL NEW SANITARY TEE IN SEPTIC TANK ② INSTALL NEW 25% REDUCTION SYSTEM ON CONTOUR AS FLAGGED ③ SET NEW DROP BOX IN EXISTING LINE TO SERIALLY FEED NEW DRAINLINES

Comments:/Conditions: INSTALLED AS DRAWN

INITIAL SITE SKETCH

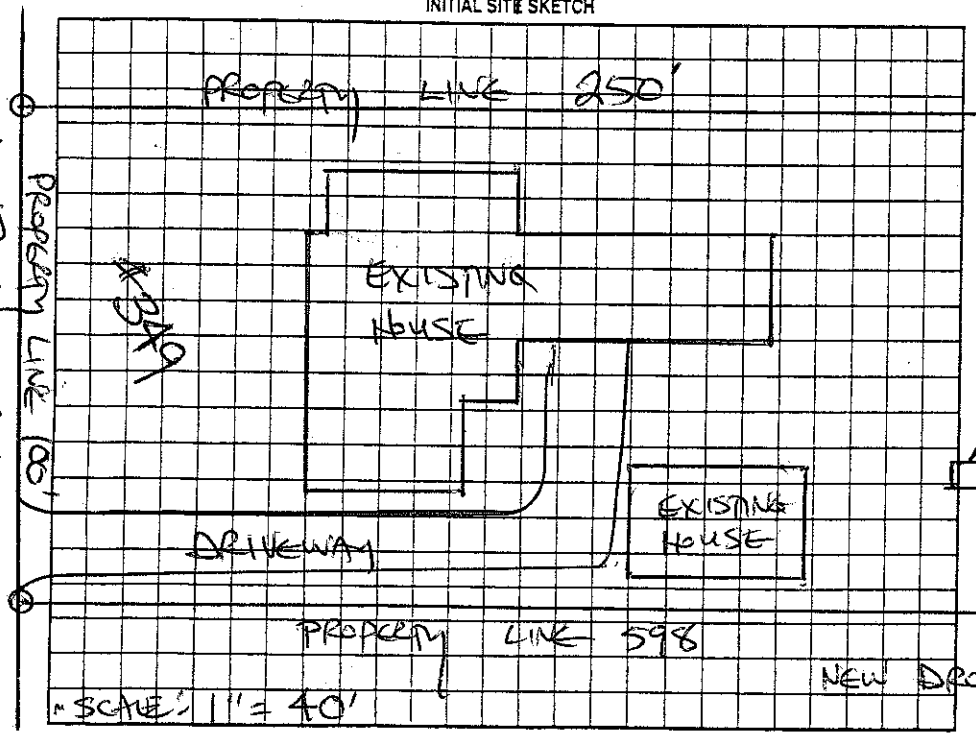

AS BUILT SKETCH

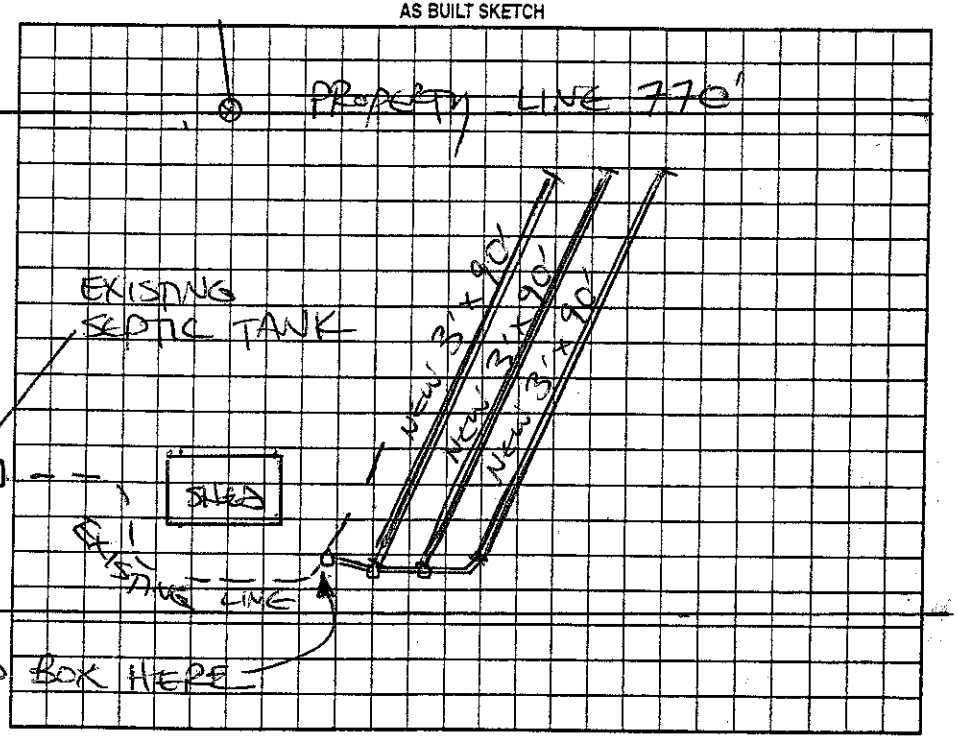

Permit can be suspended or revoked if any false information is supplied toward securing the permit/any unauthorized changes are made to the site/any unauthorized changes are made in the installation of the system. Improvement Permit with plat valid without expiration ☐ Improvement Permit with site plan valid for sixty months ☒ Authorization to Construct is valid for a period equal to that of Improvement Permit – not to exceed sixty months.

Signed: John. Ogley date 11-16-07 Installed by: JAMES HUDDLE

Improvement Permit by: STEVE HEDRICK date 11-16-07 Operation Permit by: date 11-19-07

Authorization to Construct by: STEVE HEDRICK date 11-16-07 Existing System Inspection by: date

HEALTH DEPT. COPY: WHITE OWNER COPY (FINAL): YELLOW OWNER COPY (INITIAL): PINK