IREDELL COUNTY HEALTH DEPARTMENT

STATESVILLE 704-878-5305 MOORESVILLE 704-664-5281

IMPROVEMENT PERMIT / AUTHORIZATION TO CONSTRUCT / OPERATION PERMIT / EXISTING SYSTEM INSPECTION

PERMIT# REPAIR PIN#

OWNER OR CONTRACTOR DWIGHT & JULIA BOLIN PHONE: Business Home 871-9261 DATE 3-17-98

ADDRESS 2657 FINES CREEK DRIVE, STATESVILLE, NC 28625

LOCATION NC 90 W, TR MONTICELLO DRIVE, TR JULIA LANE, SYSTEM ON LEFT BEHIND POULTRY HOUSE

SUBDIVISION REDMAN MHP BLOCK / SECTION LOT LOT AREA LIMITED SITE CLASS PS DESIGN FLOW 720 L.T.A.R. 0.25 GPD/FT²

Septic Tank: 1500 Gallons; STB 268 Date 2-1-98
Pump Tank: Gallons; PT Date
Pump Make: Model Serial No.
Nitrification Field: No Fields 1 Square Feet EST 2880 Linear Feet 720+
No Lines TEN Trench Width 36" Max Trench Bottom Depth 36"

~~Alternative System~~ ☑ Repair System Type: I, II, III, IV, V, VI
System Description: CHAMBERED GRAVITY
Repair System Description: CHAMBERED GRAVITY
Maintenance Agreement Required: ☐ Yes ☑ No

☐ House/Mod. Home No. Bedrooms 6
☑ Mobile Home (2) No. Bathrooms
☐ Business No. Employees
☐ Other TWO S/W MH's


~~Gravel~~ Depth 6" SAND ☐ Slab ☑ Crawl Space ☐ Basement w/plumbing ☐ Basement wo/plumbing

Water Supply: ☐ Individual ☑ Public ☐ Community

Comments:/Conditions: ① INSTALL 120 CHAMBERS IN TEN EQUAL LENGTH LINES AS SHOWN. ② ACCESS RISERS SHALL BE PROVIDED OVER EACH MANHOLE EXTENDING AT LEAST 6" ABOVE FINISHED GRADE.

Comments:/Conditions:

INITIAL SITE SKETCH SCALE: 1"=40'

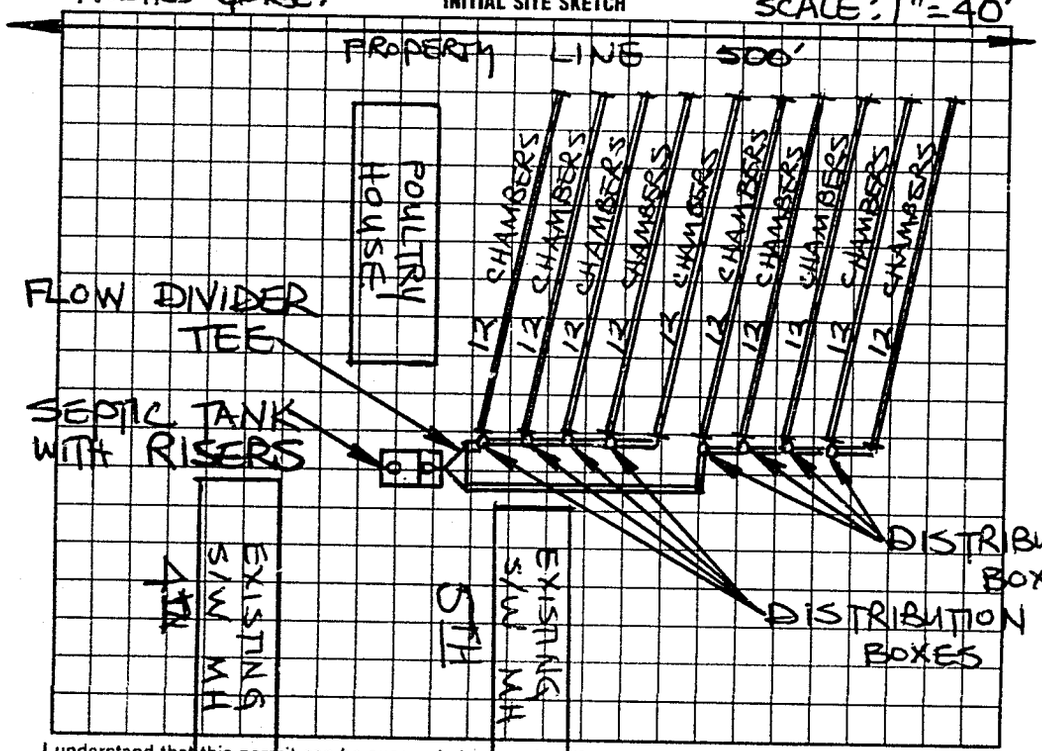

AS BUILT SKETCH

SYSTEM INSTALLED ACCORDING TO INITIAL SITE SKETCH

I understand that this permit can be suspended or revoked if any false information is supplied toward securing the permit/any unauthorized changes are made to the site/any unauthorized changes are made in the installation of the system. Improvement Permit with plat valid without expiration. Improvement Permit with site plan valid for sixty months. Authorization to Construct is valid for a period equal to that of Improvement Permit – not to exceed sixty months.

Signed: Julia R Bolin date 3-17-98

Improvement Permit by: STEVE HEDRICK date 3-17-98

Authorization to Construct by: STEVE HEDRICK date 3-17-98

Installed by: BARRY SIGMON

Operation Permit by: STEVE HEDRICK date 4-3-98

Existing System Inspection by: ~~STEVE HEDRICK~~ date

HEALTH DEPT COPY: WHITE INSPECTION COPY (FINAL): GREEN OWNER COPY (FINAL): YELLOW INSPECTION COPY (INITIAL): PINK OWNER COPY (INITIAL): GOLD