IREDELL COUNTY HEALTH DEPARTMENT

Statesville Phone TR 3-7271 — Mooresville Phone NO 3-1271

PERMIT TO INSTALL SEPTIC TANK

Permit NO. _____ Permit Date July 8 - 19 60

Owner Redman Trailer Park Address Mooresville R.

Installed By E Hoke Address R7


Location of Property old Crowson Park -

Tank	Capacity	Length of Lines	Fixtures
Block ( )	800 ( )	150' ( )	No. of Baths ( )
Precast (·)	900 ( )	175' ( )	Dishwasher ( )
Repaired old tank	1000 ( )	200' ( )	Garbage Grdr. ( )
	1100 ( )	225' ( )	Auto-Washer ( )
	1200 ( )	250' ( )	Other unknown
	Other unknown	Other 1150'	

NOTIFY HEALTH DEPARTMENT AT LEAST EIGHT HOURS BEFORE TANK IS TO BE INSPECTED.

Final Inspection _____ 19___ Approved (✓) Disapproved ( )

Remarks lines 30"X30" 8" Tufflite under tile

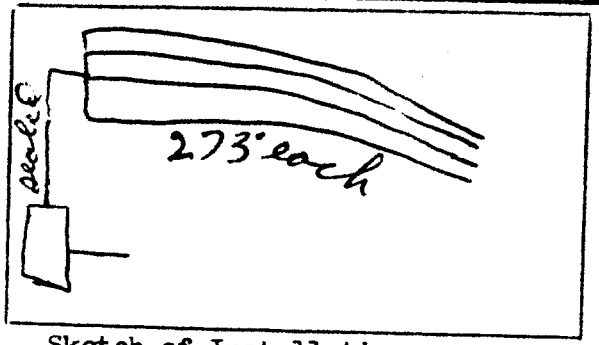

Sketch of Installation

Sanitarian