IREDELL COUNTY HEALTH DEPARTMENT

Statesville Phone TR 3-7271 Mooresville Phone NO 3-1271

PERMIT TO INSTALL SEPTIC TANK

Permit NO._____ Permit Date July 5 1961

Owner Ridgeview Trailer Park Address Rt 11 Statesville N.C.
c/o Crowson Park

Installed By Clyde Hoke Address " "


Location of Property FORMERLY CROWSON'S TRAILER CAMP
MONTICELLO DRIVE

Tank		Capacity		Length of Lines		Fixtures	
Block	( )	800	( )	150'	( )	No. of Baths	( )
Precast	( )	900	( )	175'	( )	Dishwasher	( )
Clean Tank		1000	( )	200'	( )	Garbage Grdr.	( )
		1100	( )	225'	( )	Auto-Washer	( )
		1200	( )	250'	( )	Other_____	
		Other_____		Other NEW LINE 1150 ft 30"			

NOTIFY HEALTH DEPARTMENT AT LEAST EIGHT HOURS BEFORE TANK IS TO BE INSPECTED.

Final Inspection July 5 1961 Approved (X) Disapproved ( )

Remarks

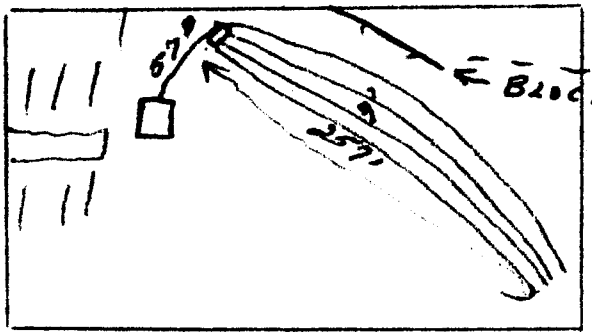

Sketch of Installation

R. W. Johnson
Sanitarian