IREDELL COUNTY HEALTH DEPARTMENT - *ENVIRONMENTAL HEALTH* ☒ STATESVILLE OFFICE 704-878-5305 ☐ MOORESVILLE OFFICE 704-664-5281

IMPROVEMENT PERMIT / AUTHORIZATION TO CONSTRUCT / OPERATION PERMIT / EXISTING SYSTEM INSPECTION

PERMIT # Repair PIN # 472554 1943 DATE 5-7-11

OWNER Henry Freeze APPLICANT: Parks Deter / PMS PHONE: Home/Cell # 704 871 0998 Business #

SITE ADDRESS 374 Monticello Dr. OWNER / APPLICANT ADDRESS 567 Laurel Cove Rd

SITE DIRECTIONS Hwy 90 N @ light, (R) on Old Hwy 90 N to (R) on Monticello School Rd., House on Left 1/4 mile

SUBDIVISION n/a (if necessary) BLOCK / SECTION n/a LOT # n/a LOT AREA 2.7 Ac. DESIGN FLOW 240 L.T.A.R. .25

Septic Tank 1000 Gallons STB 760 Date 5-23-12 ☒ New System ☐ Repair ☐ Expansion System Type I II (III) IV V VI

Pump Tank Gallons: P T Date System Description: Gravity 25% Reduction

Pump Make Model Serial # Repair System Description:

No. Nitrification Fields: 1 No. Lines 4 Linear Feet 60 Maintenance Agreement Required ☐ YES ☒ NO


Trench Width 36" Max. Trench Bottom Depth 36" Gravel Depth n/a ☒ GRAVITY ☐ PRESSURE

☒ Residence No. Bedrooms 2 ☐ Business No. Persons ☐ Other No. Employees ☐ Slab ☒ Crawl Space ☐ Basement w/plumbing ☐ Basement w/o plumbing


Water Supply ☐ Private ☒ Public ☐ Community

Comments / Conditions

INITIAL SITE SKETCH

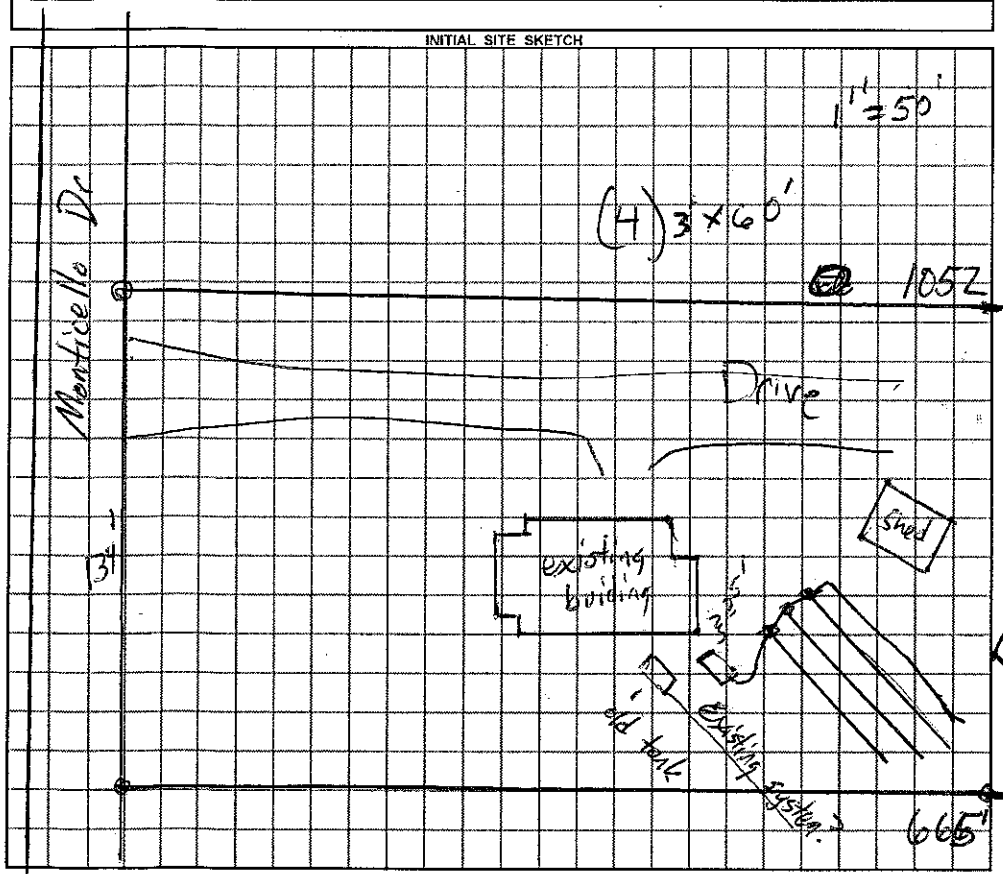

AS BUILT SKETCH

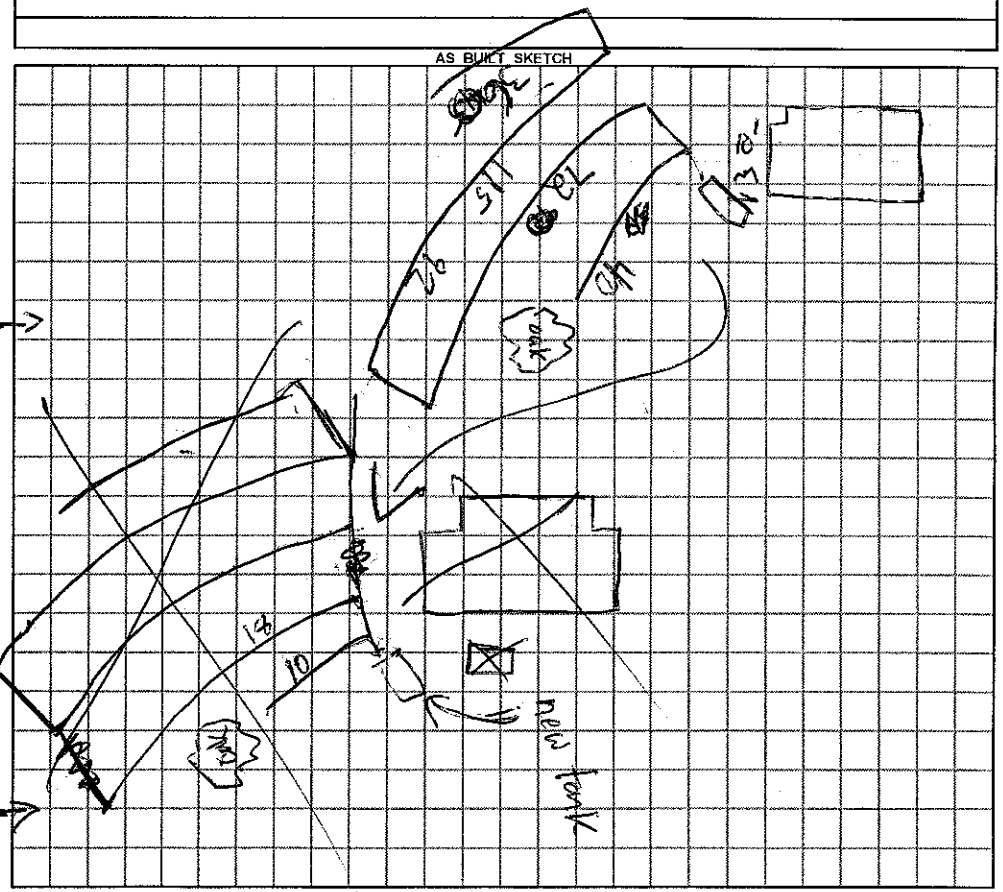

Permit can be suspended or revoked if any false information is supplied toward securing the permit / any unauthorized changes are made to the site / any unauthorized changes are made in the installation of the system.

☐ ***IMPROVEMENT PERMIT*** with plat valid without expiration. ☒ ***IMPROVEMENT PERMIT*** with plat valid without expiration. ☒ ***AUTHORIZATION TO CONSTRUCT*** valid for period equal to IMPROVEMENT PERMIT--not to exceed 60 mo.

Owner / Applicant Signature: Date site plan valid 60 mo. 5-25-12 Installed by: A-1 Backhoe

IMPROVEMENT PERMIT by: REHS Date 5-7-11 OPERATION PERMIT by: REHS Date 7-10-12

AUTHORIZATION TO CONSTRUCT by: REHS Date 5-7-11 Existing System Inspected by: REHS Date

YOU SHOULD CONTACT A LOCATOR SERVICE PRIOR TO ANY EXCAVATION

White Copy – Environmental Health YELLOW COPY (Final) Owner / Applicant PINK COPY (Initial) Owner / Applicant