IREDELL COUNTY HEALTH DEPARTMENT

STATESVILLE 704-878-5305 MOORESVILLE 704-664-5281

IMPROVEMENT PERMIT / AUTHORIZATION TO CONSTRUCT / OPERATION PERMIT / EXISTING SYSTEM INSPECTION

PERMIT# REPAIR PIN# 4725-54-6599 DATE 7-21-05

OWNER OR CONTRACTOR JIM A. TAYLOR PHONE: Business 704-872-0404 Home 704-872-9752

ADDRESS 348 MONTICELLO DRIVE, STATESVILLE, NC 28625-2329

LOCATION NC 115 N, TL OLD WILKESBORO RD, TL BRADLEY FARM RD, TL MONTICELLO DR, 2ND HOUSE ON LEFT PAST MILLER FARM ROAD.

SUBDIVISION BLOCK / SECTION LOT LOT AREA 0.69 ACRE SITE CLASS. P'S DESIGN FLOW 360 L.T.A.R. EXISTING

Septic Tank: EXISTING Gallons; STB Date

Pump Tank: Gallons; PT Date

Pump Make: Model Serial No.

Nitrification Field: No Fields 1 Square Feet Linear Feet EXISTING

No Lines EXISTING Trench Width Max Trench Bottom Depth Gravel Depth

☐ New System ☑ Repair System Type: I, II, III, IV, V, VI

System Description: CONVENTIONAL, GRAVITY

Repair System Description: CONVENTIONAL, GRAVITY

Maintenance Agreement Required: ☐ Yes ☑ No

☑ House/Mod. Home No. Bedrooms 3

☐ Mobile Home No. Bathrooms 2

☐ Business No. Employees

☐ Other


☐ Slab ☑ Crawl Space ☐ Basement w/plumbing ☐ Basement wo/plumbing

Water Supply: ☐ Individual ☑ Public ☐ Community


Comments:/Conditions: EXCAVATE EXISTING SUPPLY LINE TO DETERMINE AREA of BLOCKAGE. REPLACE EXISTING COMPONENTS AS NECESSARY. CONTACT HEALTH DEPT. FOR FINAL INSPECTION.

Comments:/Conditions: THIS PERMIT SERVES AS "NOTICE OF VIOLATION", SYSTEM TO BE REPAIRED BY 8-22-05

INITIAL SITE SKETCH

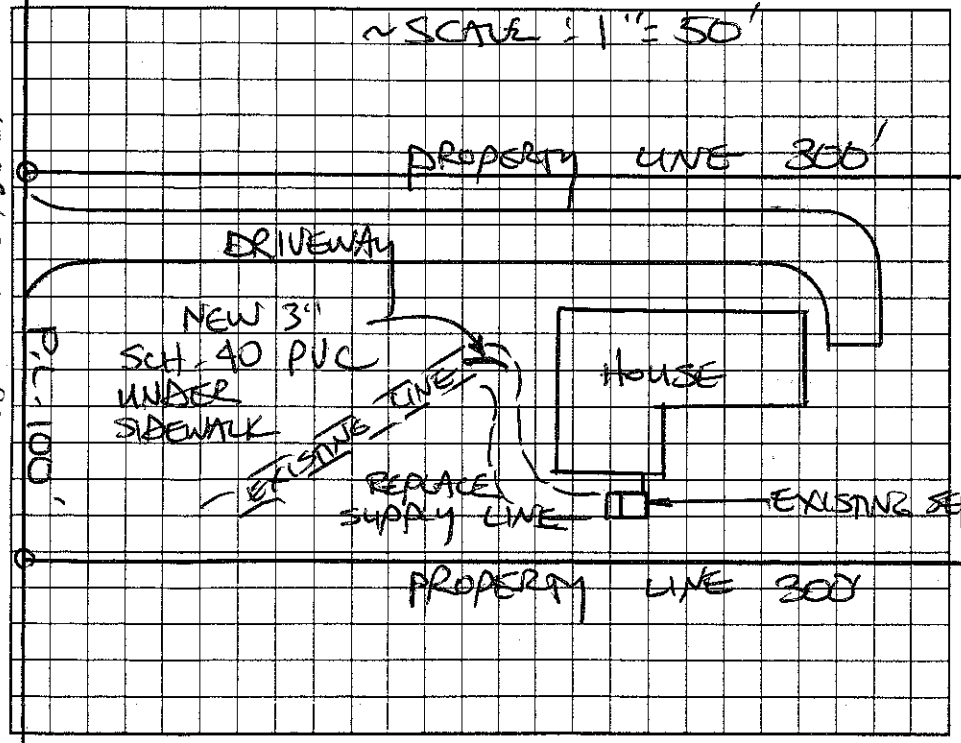

AS BUILT SKETCH

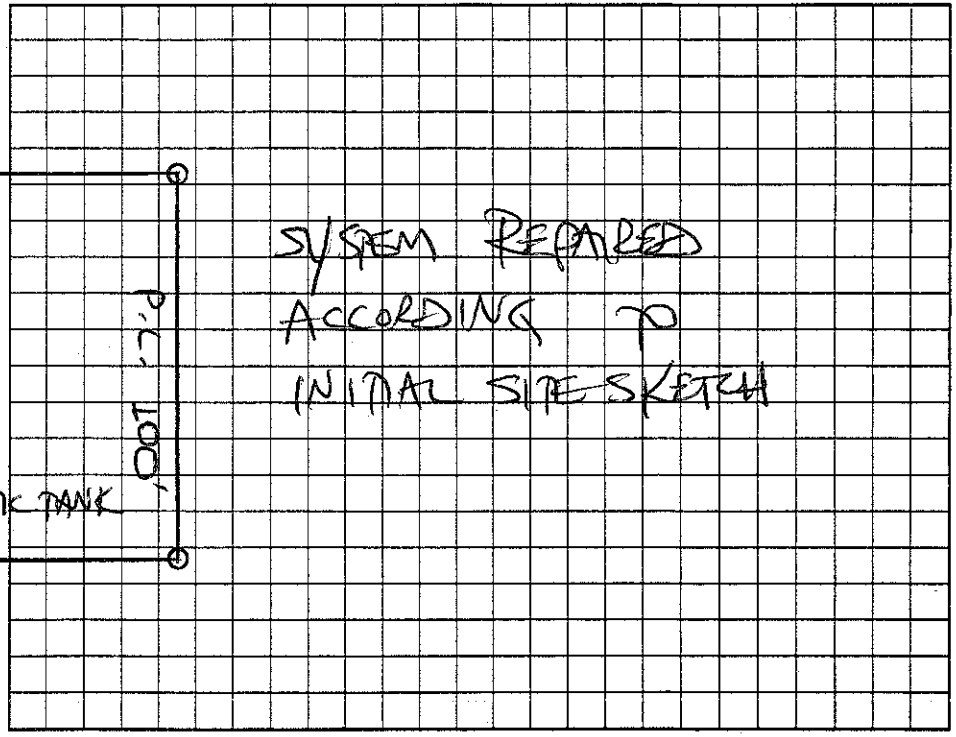

Permit can be suspended or revoked if any false information is supplied toward securing the permit/any unauthorized changes are made to the site/any unauthorized changes are made in the installation of the system. Improvement Permit with plat valid without expiration. Improvement Permit with site plan valid for sixty months. Authorization to Construct is valid for a period equal to that of Improvement Permit – not to exceed sixty months.

Signed Jim Taylor OR date 7-21-05 Installed by: JARED LENTZ

Improvement Permit by: STEVE HEDRICK date 7-21-05 Operation Permit by: STEVE HEDRICK date 8-2-05

Authorization to Construct by: STEVE HEDRICK date 7-21-05 Existing System Inspection by: date

HEALTH DEPT. COPY: WHITE OWNER COPY (FINAL): YELLOW OWNER COPY (INITIAL): PINK