48586

IREDELL COUNTY HEALTH DEPARTMENT

STATESVILLE 704-878-5305 MOORESVILLE 704-664-5281

IMPROVEMENT PERMIT / CERTIFICATE OF COMPLETION / OPERATION PERMIT / EXISTING SYSTEM INSPECTION

PROPERTY DESCRIPTION NO. CITY DATE 8/30/93 TAX MAP NO. 6K-20-A-24

OWNER OR CONTRACTOR TERRY O'BRIEN PHONE: Business 592-5501 Home 871-1536

ADDRESS Rt. 2 Box 226 STATESVILLE, NC. 28677

LOCATION NC 90 W TR; MONTICELLO DR, LOT ON (L) AT NORTHWEST CORNER OF MILLER FARM RD

SUBDIVISION SUNNYDALE BLOCK / SECTION II LOT 24 LOT AREA 125X235 SITE CLASS. P3 L.T.A.R. 0.35 GPD/FT²

Water Supply: ☐ Individual ☐ Community ☑ Public

Septic Tank: 1000 Gallons: STB 358 Date 7/27/93

Pump Tank: ____ Gallons: PT ____ Date ____

Nitrification Field: No Fields 1 Square Feet 1035 Linear Feet 345

No Lines 3 Trench Width 36" Trench Depth 18-36" Gravel Depth 12"

☐ New System ☐ Repair System Type: I, II, III, IV, V, VI

System Description: CONV. GRAVITY

Repair System Description: CONV GRAVITY

Maintenance Agreement Required: ☐ Yes ☑ No

☑ House/Mod. Home No. Bedrooms 3

☐ Mobile Home No. Bathrooms 2

☐ Business No. Employees ____

☐ Other ____

Garbage Disposal: ☐ Yes ☑ No

Auto. Dishwasher: ☑ Yes ☐ No


Auto. Washing Machine: ☑ Yes ☐ No

Other ____


☑ Slab ☐ Crawl Space ☐ Basement w/plumbing ☐ Basement wo/plumbing

Comments (1) KEEP SYSTEM MINIMUM 5' FROM HOUSE, 10' FROM PROP. LINE, 10' FROM WATER LINE (2) INSTALL LINES ON CONTOUR, NO DEEPER THAN 36", 9' APART ON CENTER.

INITIAL SITE SKETCH

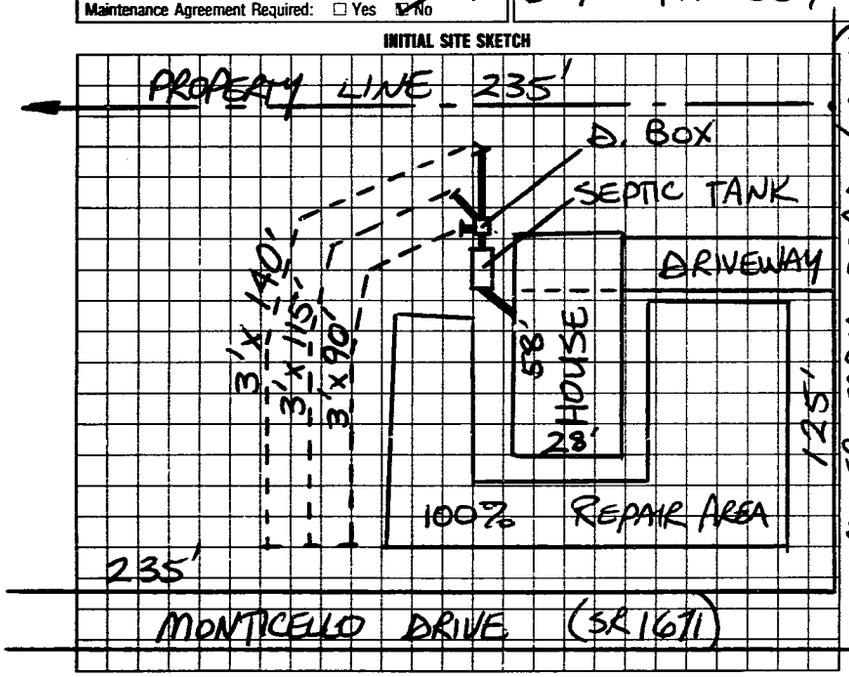

AS BUILT SKETCH

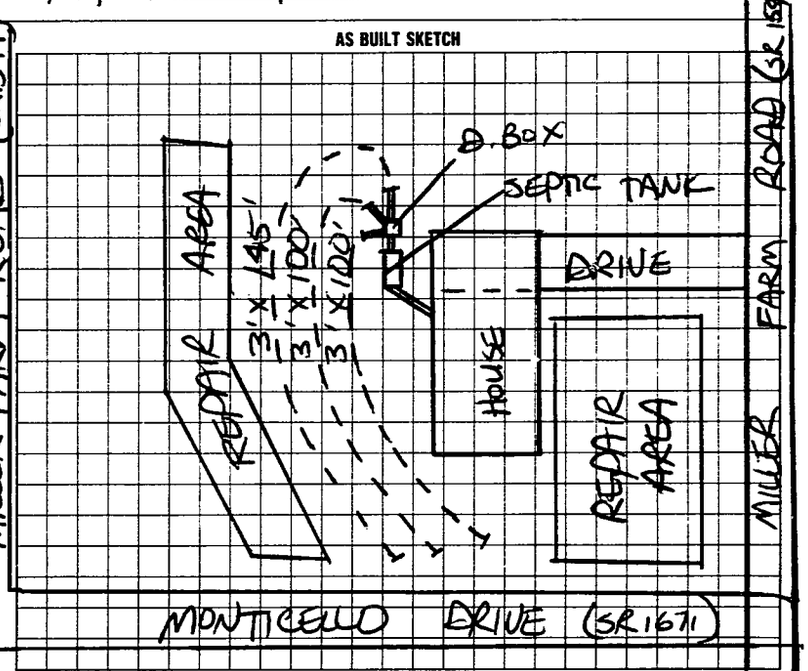

I understand that this permit can be suspended or revoked if any false information is supplied toward securing the permit/any unauthorized changes are made to the site/any unauthorized changes are made in the installation of the system. Improvement Permit is valid for 60 months from date of issuance.

Signed: [signature]

Improvement Permit by: STEVE HEDRICK date 8/30/93

Existing System Inspection by: ____ date ____

Installed by: A-1 BACKHOE

Certificate of Completion by: STEVE HEDRICK date 9/8/93

Operation Permit by: ____ date ____

HEALTH DEPT. COPY: WHITE INSPECTION COPY (FINAL): GREEN OWNER COPY (FINAL): YELLOW INSPECTION COPY (INITIAL): PINK OWNER COPY (INITIAL): GOLD