IREDELL COUNTY HEALTH DEPARTMENT

STATESVILLE 704-878-5305 — MOORESVILLE 704-664-5281

48587

IMPROVEMENT PERMIT / CERTIFICATE OF COMPLETION / OPERATION PERMIT / EXISTING SYSTEM INSPECTION

PROPERTY DESCRIPTION NO. CITY — DATE 8/30/93

OWNER OR CONTRACTOR RICHARD CRANDALL — PHONE: Business 871-1536 — TAX MAP NO. 6K-20-A-23

ADDRESS RT-2 Box 226 STATESVILLE NC 28677 — Home 592-5901

LOCATION NC 90 W, TR MONTICELLO DR, TL MILLER FARM ROAD

SUBDIVISION — BLOCK / SECTION — LOT — LOT AREA 125x235 — SITE CLASS. PS — L.T.A.R. 0.35 GPD/FT²

Water Supply: ☐ Individual ☐ Community ☑ Public

Septic Tank: 1000 Gallons: STB 7/22/93 Date 9/2/93

Pump Tank: — Gallons; PT — Date

Nitrification Field: No Fields 1 — Square Feet 1035 — Linear Feet 345

No Lines 3 — Trench Width 36" — Trench Depth 18-36" — Gravel Depth 12"

☑ New System ☐ Repair — System Type: I (II) III, IV, V, VI

System Description: CONV. GRAVITY

Repair System Description: CONV. GRAVITY

Maintenance Agreement Required: ☐ Yes ☑ No

☑ House/Mod. Home — No. Bedrooms 3

☐ Mobile Home — No. Bathrooms 2

☐ Business — No. Employees —

☐ Other —

Garbage Disposal: ☐ Yes ☑ No

Auto. Dishwasher: ☑ Yes ☐ No


Auto. Washing Machine: ☑ Yes ☐ No

Other —

☑ Slab ☐ Crawl Space ☐ Basement w/plumbing ☐ Basement wo/plumbing

Comments (1) KEEP SYSTEM MINIMUM 5' FROM HOUSE, 10' FROM PROPERTY LINE, 10' FROM WATER LINE (2) INSTALL LINES ON CONTOUR, NO DEEPER THAN 36", 9' APART ON CENTER

INITIAL SITE SKETCH

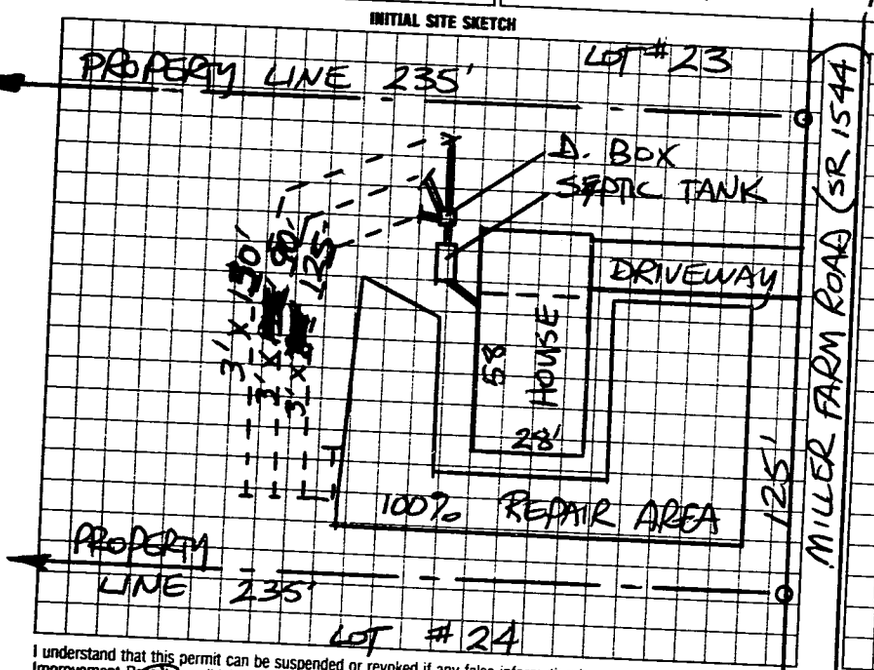

AS BUILT SKETCH

SYSTEM INSTALLED ACCORDING TO INITAL SITE SKETCH

I understand that this permit can be suspended or revoked if any false information is supplied toward securing the permit/any unauthorized changes are made to the site/any unauthorized changes are made in the installation of the system. Improvement Permit is valid for 60 months from date of issuance.

Signed: X

Improvement Permit by: STEVE HEDRICK date 8/30/93

Existing System Inspection by: — date —

Installed by: A-1 BACKHOE

Certificate of Completion by: STEVE HEDRICK date 9/2/93

Operation Permit by: — date —

HEALTH DEPT. COPY: WHITE — INSPECTION COPY (FINAL): GREEN — OWNER COPY (FINAL): YELLOW — INSPECTION COPY (INITIAL): PINK — OWNER COPY (INITIAL): GOLD