3:00 Rick Shook

IREDELL COUNTY HEALTH DEPARTMENT

STATESVILLE 704-878-5305 MOORESVILLE 704-664-5281

IMPROVEMENT PERMIT / CERTIFICATE OF COMPLETION / OPERATION PERMIT / EXISTING SYSTEM INSPECTION

PROPERTY DESCRIPTION NO. Statesville DATE 4-4-97 TAX MAP NO. 6K-20-A-6 Watershed: ☐ Yes ☑ No

OWNER OR CONTRACTOR Carl Teague PHONE: Business _____ Home 873 4887

ADDRESS _____

LOCATION 90W TR mountain Island Fork Rd Or. Th miller Fire Rd 1000' on left

SUBDIVISION Sunnydale BLOCK / SECTION _____ LOT 21 LOT AREA 1.1 acre SITE CLASS. P5 DESIGN FLOW 480 L.T.A.R. .4

Septic Tank: Ex. Gallons; STB _____ Date _____

Pump Tank: _____ Gallons; PT _____ Date _____

Pump Make: _____ Model _____ Serial No. _____

Nitrification Field: No Fields 1 Square Feet 300 Linear Feet 100

No Lines 2 Trench Width 36" Max Trench Bottom Depth 36" Gravel Depth 12"

☐ New System ☑ Repair System Type: I, II, III, IV, V, VI

System Description: _____

Repair System Description: Addition to Bring up to 480

Maintenance Agreement Required: ☐ Yes ☑ No

☐ House/Mod. Home ☐ Mobile Home ☐ Business ☐ Other _____

No. Bedrooms 4 No. Bathrooms 3 No. Employees _____

☐ Slab ☑ Crawl Space ☐ Basement w/plumbing ☐ Basement wo/plumbing


Water Supply: ☐ Individual ☐ Community ☑ Public

Comments:

Existing System Was 1000 gal S.T. 300' of Drain line for 3 bedroom Home Carl Teague 1-3-89

Comments:

INITIAL SITE SKETCH

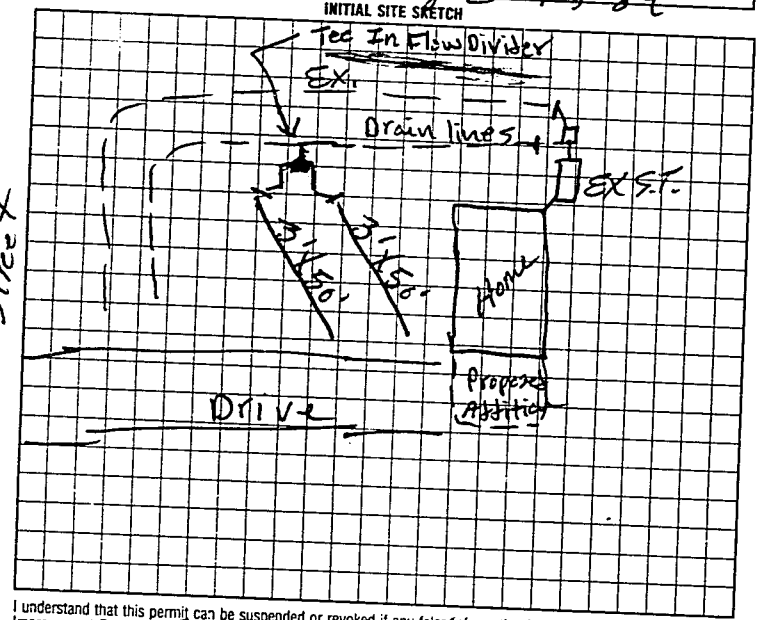

AS BUILT SKETCH

Same as initial sketch

I understand that this permit can be suspended or revoked if any false information is supplied toward securing the permit/any unauthorized changes are made to the site/any unauthorized changes are made in the installation of the system. Improvement Permit is valid for 60 months from date of issuance.

Signed: X [signature]

Improvement Permit by: P.C. Moore date 4-4-97

Authorization to Install Existing System by: P.C. Moore date 4-4-97

Installed by: Rick Shook

Certificate of Completion by: _____ date _____

Operation Permit by: P.C. Moore date 4-22-97

Authorization to cont. Expires 60 mos from date issued

HEALTH DEPT. COPY WHITE INSPECTION COPY (FINAL) GREEN OWNER COPY (FINAL) YELLOW INSPECTION COPY (INITIAL) PINK OWNER COPY (INITIAL) GOLD