IREDELL COUNTY HEALTH DEPARTMENT

STATESVILLE 704-878-5305 ✓ MOORESVILLE 704-664-5281

IMPROVEMENT PERMIT / AUTHORIZATION TO CONSTRUCT / OPERATION PERMIT / EXISTING SYSTEM INSPECTION

PERMIT# 100835 PIN# 4725-55-4789.3 DATE 11/8/01

OWNER OR CONTRACTOR Khan Charthaburg PHONE: Business — Home (704) 878-0586

ADDRESS 110 Lionsthorp Lane Statesville, N.C. 28677

LOCATION Hwy 115 N. @ Scotts Creek Rd, @ Millar Farm Rd, @ on Hannah Brooke on Left.

SUBDIVISION Charthaburg Village BLOCK / SECTION — LOT 3 LOT AREA .95 Acre SITE CLASS. V5 DESIGN FLOW 360 L.T.A.R. [redacted].25

Septic Tank: 4,000 Gallons; STB 357 Date 6-6-02
Pump Tank: — Gallons; PT — Date —
Pump Make: — Model — Serial No. —
Nitrification Field: No Fields 1 Square Feet 1450 Linear Feet LEO
No Lines [redacted] Trench Width 36" Max Trench Bottom Depth 30" Gravel Depth 12"

☒ New System ☐ Repair System Type: I, (II), III, IV, V, VI
System Description: Gravity, Conventional
Repair System Description: Pump, Site Evaluation
Maintenance Agreement Required: ☐ Yes ☒ No


☒ House/Mod. Home No. Bedrooms 3
☐ Mobile Home No. Bathrooms 2
☐ Business No. Employees —
☐ Other —
☐ Slab ☒ Crawl Space ☐ Basement w/plumbing ☐ Basement wo/plumbing

Water Supply: ☒ Individual ☐ Public ☐ Community

Comments/Conditions: (1) Install Lines on Contour (2) Do not install when wet (3) Use Stallions drop box or dist box w/ 4 speed holes (4) Mention proper Setbacks.

Comments/Conditions: - Septic Tank marker installed
Poly Tube filter installed

INITIAL SITE SKETCH Hannah Brooke

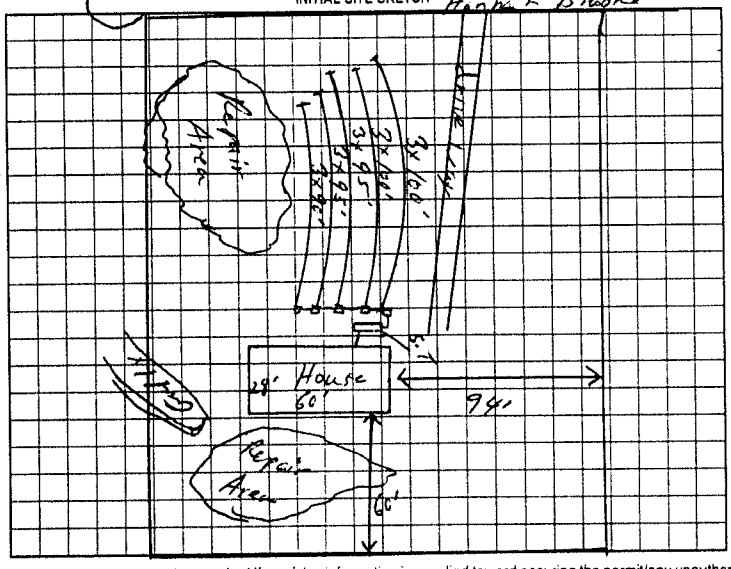

AS BUILT SKETCH

Installed as Shown

Permit can be suspended or revoked if any false information is supplied toward securing the permit/any unauthorized changes are made to the site/any unauthorized changes are made in the installation of the system. Improvement Permit with plat valid without expiration. Improvement Permit with site plan valid for sixty months. Authorization to Construct is valid for a period equal to that of Improvement Permit – not to exceed sixty months.

Signed: Sara Hodgdon date 11-8-01

Improvement Permit by: William O. Johnson date 11/8/01

Authorization to Construct by: William O. Johnson date 11/8/01

Operation Permit Installed by: William O. Johnson

Operation Permit Installed by: G+M Contractors date 1/11/02

Existing System Inspection by: — date —

HEALTH DEPT. COPY: WHITE OWNER COPY (FINAL): YELLOW OWNER COPY (INITIAL): PINK