Note: This permit Voids previously issued permit dated 11/8/01.

IREDELL COUNTY HEALTH DEPARTMENT

STATESVILLE 704-878-5305 ✓ MOORESVILLE 704-664-5281

IMPROVEMENT PERMIT / AUTHORIZATION TO CONSTRUCT / OPERATION PERMIT / EXISTING SYSTEM INSPECTION

PERMIT# 100836 PIN# 4725-55-4736.2 DATE 1/16/02

OWNER OR CONTRACTOR Adam Chantal Autry PHONE: Business Home (704) 878-0586

ADDRESS 110 Lunaethe Lane Statesville, NC 28625

LOCATION Hwy 115 North @ Scotts Creek Rd @ Miller Farm Rd, on Hanna Brooke on Right

SUBDIVISION Hawthekaw Village BLOCK / SECTION — LOT 2 LOT AREA 1.0 SITE CLASS 75 DESIGN FLOW 360 L.T.A.R. .25

Septic Tank: 1,000 Gallons: STB 354 Date 6-13-01
Pump Tank: ____ Gallons: PT ____ Date ____
Pump Make: ____ Model ____ Serial No. ____
Nitrification Field: No. Fields 1 Square Feet 1440 Linear Feet 360'
No. Lines 4 Trench Width 36" Max Trench Bottom Depth 36" Gravel Depth —

☒ New System ☐ Repair System Type: I, II, III, IV, V, VI
System Description: Gravity, 25% Reduction
Repair System Description: Pump, 25% Reduction
Maintenance Agreement Required: ☐ Yes ☒ No

☒ House/Mod. Home ☐ Mobile Home ☐ Business ☐ Other
No. Bedrooms 3 No. Bathrooms 2 No. Employees ____


☐ Slab ☒ Crawl Space ☐ Basement w/plumbing ☐ Basement wo/plumbing

Water Supply: ☐ Individual ☒ Public ☐ Community

Comments/Conditions: ① maintain proper setbacks ② Install System lines on contour ③ Do Not install when wet ④ Install 25% Reduction System

Comments/Conditions: - Septic Tank Marker Installed - 60 Infiltrator Chambers Installed (4 Lines 4/13/20/16 bottom line) # of Chambers 1 Poly Inlet Filter Installed

INITIAL SITE SKETCH

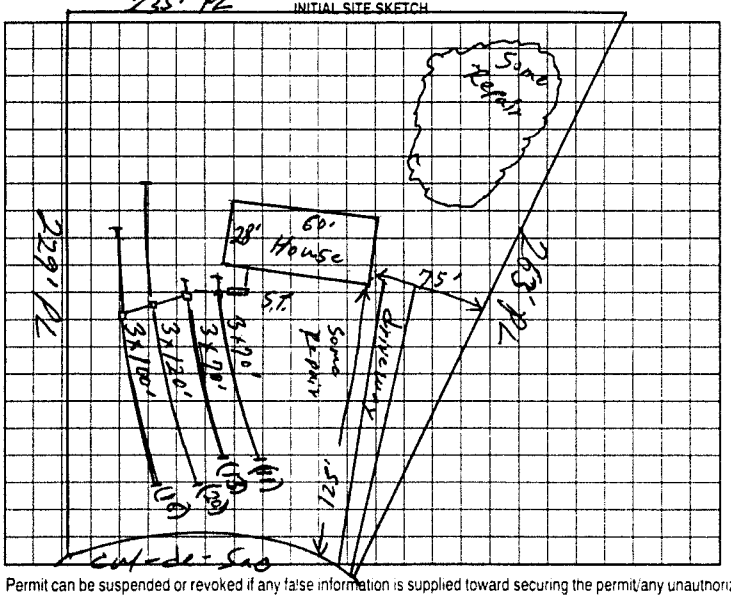

AS BUILT SKETCH

Installed as shown per Initial Site Sketch

Permit can be suspended or revoked if any false information is supplied toward securing the permit/any unauthorized changes are made to the site/any unauthorized changes are made in the installation of the system. Improvement Permit with plat valid without expiration. Improvement Permit with site plan valid for sixty months. Authorization to Construct is valid for a period equal to that of Improvement Permit - not to exceed sixty months.

Signed ✕ Matt Overberg date 1/16/02 Installed by: G+M Enterprises

Improvement Permit by: William O. Johnson date 1/16/02 Operation Permit by: William O. Johnson date 1/16/02

Authorization to Construct by: William O. Johnson date 1/16/02 Existing System Inspection by: ____ date ____

HEALTH DEPT COPY WHITE OWNER COPY (FINAL) YELLOW OWNER COPY (INITIAL) PINK