IREDELL COUNTY HEALTH DEPARTMENT - *ENVIRONMENTAL HEALTH* ☒ STATESVILLE OFFICE 704-878-5305 ☐ MOORESVILLE OFFICE 704-664-5281

IMPROVEMENT PERMIT / AUTHORIZATION TO CONSTRUCT / OPERATION PERMIT / EXISTING SYSTEM INSPECTION ②

PERMIT # 168824 PIN # 4725-56-4262 DATE 10-14-11

OWNER Martin + Tammy Chavez APPLICANT: PHONE: Home/Cell # 704-871-8330 Business #

SITE ADDRESS 135 Hall Dr. OWNER / APPLICANT ADDRESS same

SITE DIRECTIONS I-77N (L) Scotts Creek (L) Miller Farm, site on right before Monticello Dr.

SUBDIVISION Sunnydale BLOCK / SECTION n/a LOT # 11 LOT AREA 1.055 DESIGN FLOW 360 L.T.A.R. .3

Septic Tank 1000 Gallons: STB 794 Date 11-27-96

Pump Tank Gallons: P T Date

Pump Make Model Serial #

No. Nitrification Fields: 1 No. Lines 3 Linear Feet 400

Trench Width 3 Max. Trench Bottom Depth 36

☒ New System ☐ Repair ☐ Expansion System Type I (II) III IV V VI

System Description: Conventional Gravity

Repair System Description: Conventional Pump

Maintenance Agreement Required ☐ YES ☒ NO

Gravel Depth 12" ☒ GRAVITY ☐ PRESSURE

☒ Residence No. Bedrooms 3

☐ Business No. Persons

☐ Other No. Employees


☐ Slab ☐ Crawl Space

☐ Basement w/plumbing ☐ Basement w/o plumbing


Water Supply: ☐ Private ☒ Public ☐ Community

Comments / Conditions

INITIAL SITE SKETCH

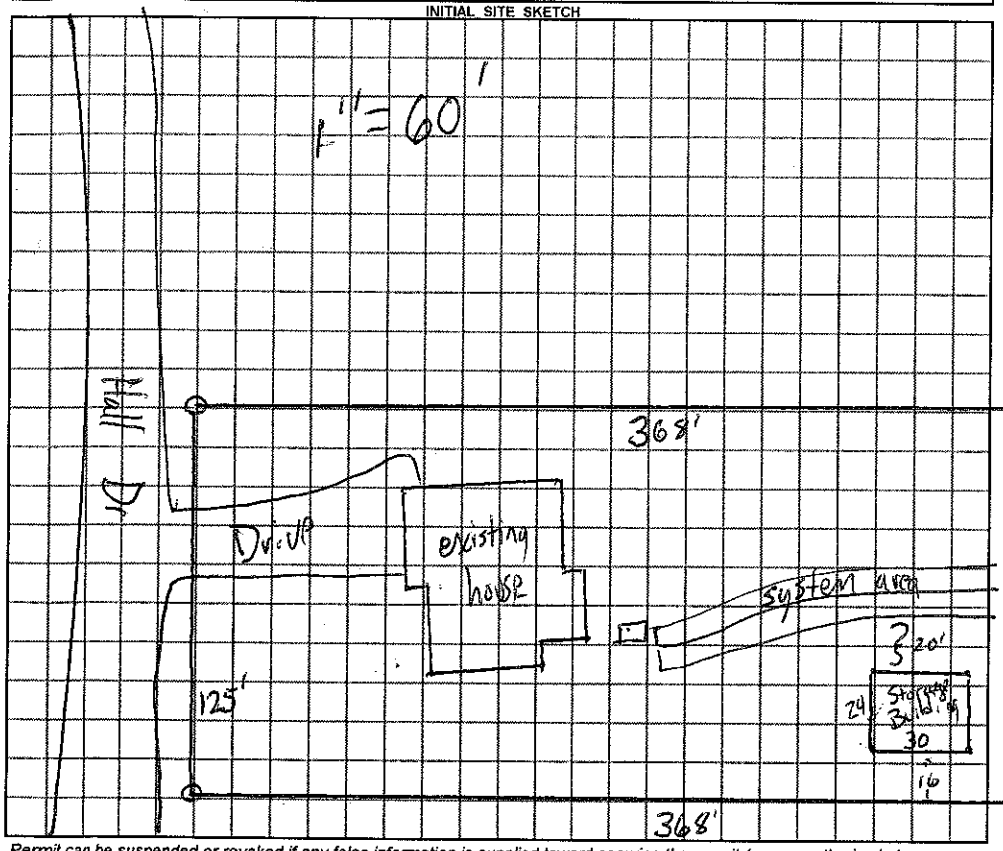

AS BUILT SKETCH

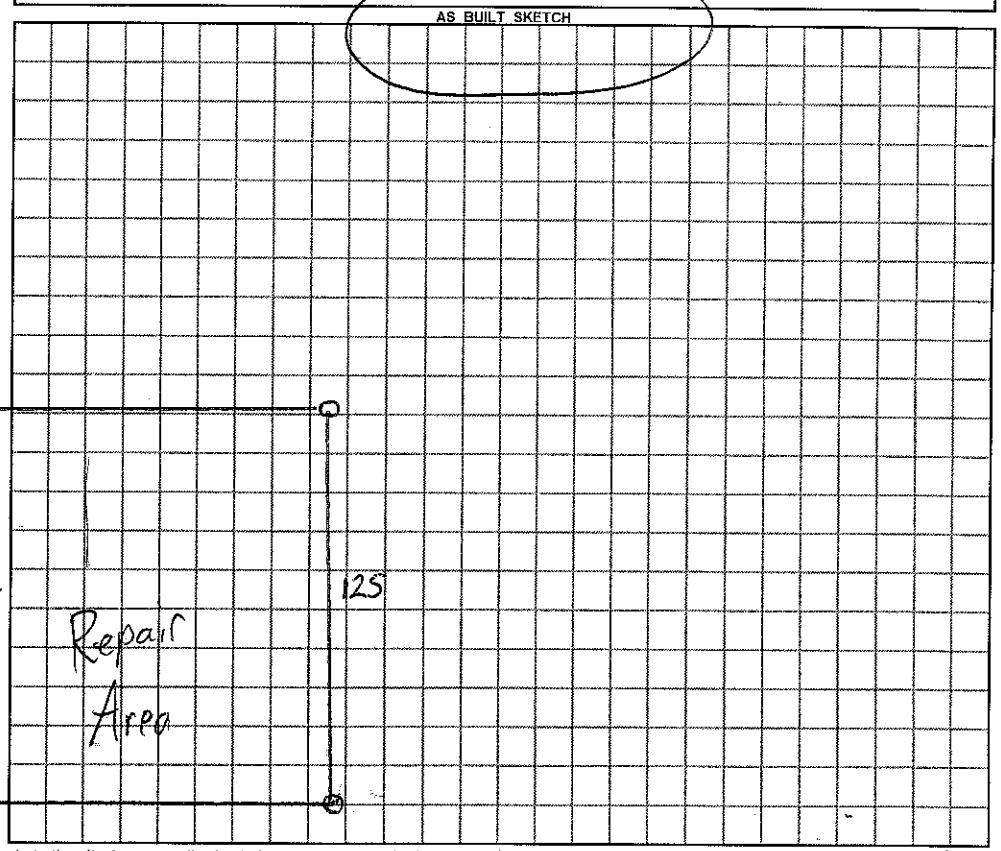

Permit can be suspended or revoked if any false information is supplied toward securing the permit / any unauthorized changes are made to the site / any unauthorized changes are made in the installation of the system.

☐ ***IMPROVEMENT PERMIT*** with plat valid without expiration ☐ ***IMPROVEMENT PERMIT*** with plat valid without expiration. ☐ ***AUTHORIZATION TO CONSTRUCT*** valid for period equal to IMPROVEMENT PERMIT--not to exceed 60 mo.

site plan valid 60 mo.

Owner / Applicant Signature: Martin Chavez Date 10-14-11 Installed by:

IMPROVEMENT PERMIT by: REHS Date

AUTHORIZATION TO CONSTRUCT by: REHS Date

OPERATION PERMIT by: REHS Date

Existing System Inspected by: REHS Date 10-14-11

YOU SHOULD CONTACT A LOCATOR SERVICE PRIOR TO ANY EXCAVATION

White Copy – Environmental Health YELLOW COPY (Final) Owner / Applicant PINK COPY (Initial) Owner / Applicant