IREDELL COUNTY HEALTH DEPARTMENT

STATESVILLE 704-878-5305 MOORESVILLE 704-664-5281

IMPROVEMENT PERMIT / CERTIFICATE OF COMPLETION / OPERATION PERMIT / EXISTING SYSTEM INSPECTION

PROPERTY DESCRIPTION NO. 12149 DATE 6/24/93

OWNER OR CONTRACTOR HERITAGE BLDG Co. PHONE: Business TAX MAP NO. 9D-A-55

ADDRESS Home

LOCATION NC 90 W, TR MONTICELLO DR, TL MILLER FARM RD, TL BEECH BROOK LN, LOT on (15)

SUBDIVISION PINEY OAKS BLOCK / SECTION LOT 42 LOT AREA 0.999 AC SITE CLASS. PS L.T.A.R. 0.35 GPD/FT²

Water Supply: ☐ Individual ☐ Community ☐ Public

Septic Tank: 1250 Gallons; STB 564 Date 6/2/92

Pump Tank: Gallons; PT Date

Nitrification Field: No Fields 1 Square Feet 1035 Linear Feet 345

No Lines 3 Trench Width 36" Trench Depth ~24" Gravel Depth 12"

☒ New System ☐ Repair System Type: I, II, II, IV, V, VI

System Description: CONV. GRAVITY

Repair System Description: CONV. GRAVITY

Maintenance Agreement Required: ☐ Yes ☒ No

☐ House/Mod. Home No. Bedrooms 3

☐ Mobile Home No. Bathrooms 2

☐ Business No. Employees

☐ Other

☐ Slab ☒ Crawl Space ☐ Basement w/plumbing ☐ Basement wo/plumbing

Garbage Disposal: ☒ Yes ☐ No

Auto. Dishwasher: ☒ Yes ☐ No


Auto. Washing Machine: ☒ Yes ☐ No

Other

Comments SYSTEM UPGRADED TO ACCOMODATE 0.35 GPD/FT²

INITIAL SITE SKETCH

AS BUILT SKETCH

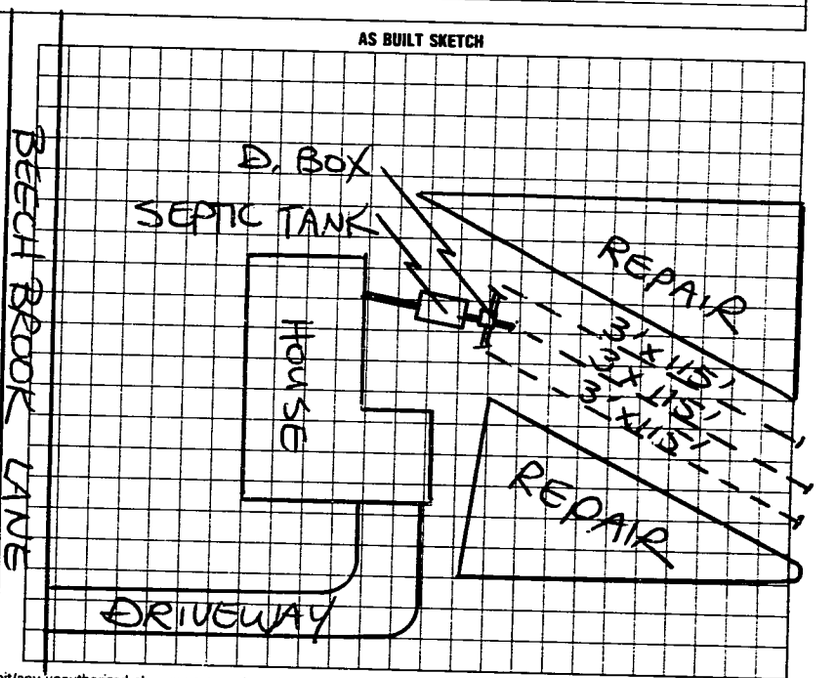

I understand that this permit can be suspended or revoked if any false information is supplied toward securing the permit/any unauthorized changes are made to the site/any unauthorized changes are made in the installation of the system. Improvement Permit is valid for 60 months from date of issuance.

Signed:

Improvement Permit by: STEVE HEDRICK date 11/13/90

Existing System Inspection by: date

Installed by: WES LYTTON

Certificate of Completion by: STEVE HEDRICK date 6/24/93

Operation Permit by: date

HEALTH DEPT. COPY: WHITE INSPECTION COPY (FINAL). GREEN OWNER COPY (FINAL): YELLOW INSPECTION COPY (INITIAL): PINK OWNER COPY (INITIAL): GOLD