IREDELL COUNTY HEALTH DEPARTMENT

STATESVILLE 704-878-5305 MOORESVILLE 704-664-5281

IMPROVEMENT PERMIT / CERTIFICATE OF COMPLETION / OPERATION PERMIT / EXISTING SYSTEM INSPECTION

PROPERTY DESCRIPTION NO. 18925 DATE 8/23/94 TAX MAP NO. 9D-13-A-43 Watershed: ☐ Yes ☒ No

OWNER OR CONTRACTOR ANDREW C. KILLINBECK PHONE: Business 878-9450 Home 838-0758

ADDRESS RT. 17, BOX 443, STATESVILLE, NC 28677

LOCATION NC 90 W., TR MONTICELLO, TL MILLER FARM RD TL BEECH BROOK LN, LOT #43 ON LEFT

SUBDIVISION PINEY OAKS BLOCK / SECTION ____ LOT 43 LOT AREA 130'x325' SITE CLASS. PS DESIGN FLOW 360 L.T.A.R. 0.35 GPD/FT2

Septic Tank: 1000 Gallons; STB 794 Date 5/11/93

Pump Tank: ____ Gallons; PT ____ Date ____

Pump Make: ____ Model ____ Serial No. ____

Nitrification Field: No Fields 1 Square Feet 345 Linear Feet 345'

No Lines 3 Trench Width 36" Max Trench Bottom Depth ____ Gravel Depth 12"

☐ New System ☐ Repair System Type: I, II, III, IV, V, VI

System Description: CONV. GRAVITY

Repair System Description: CONV. GRAVITY/PUMP

Maintenance Agreement Required: ☐ Yes ☒ No

☒ House/Mod. Home No. Bedrooms 3

☐ Mobile Home No. Bathrooms 2

☐ Business No. Employees ____

☐ Other ____


☐ Slab ☒ Crawl Space ☐ Basement w/plumbing ☐ Basement wo/plumbing

Water Supply: ☐ Individual ☐ Community ☒ Public


Comments:

Comments: APPROXIMATELY 40' DRAINFIELD COVERED BY FILL DIRT WHICH MAY AFFECT SYSTEM LIFESPAN

INITIAL SITE SKETCH

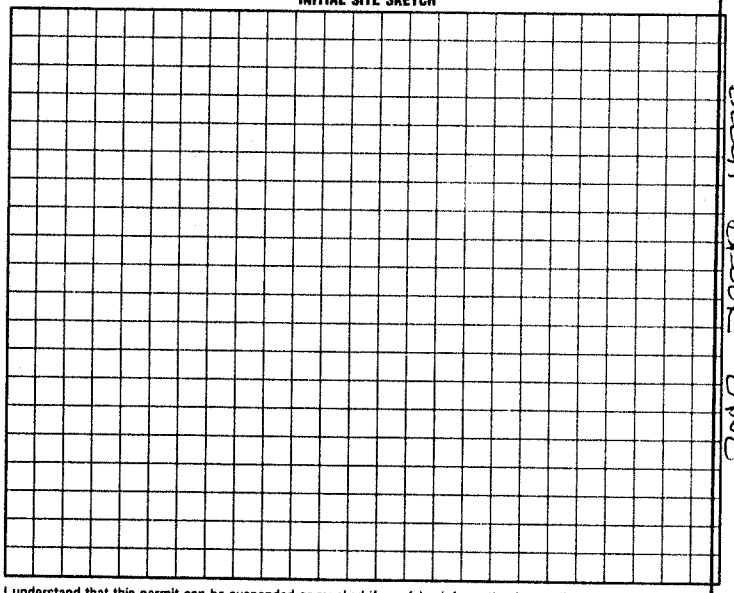

AS BUILT SKETCH

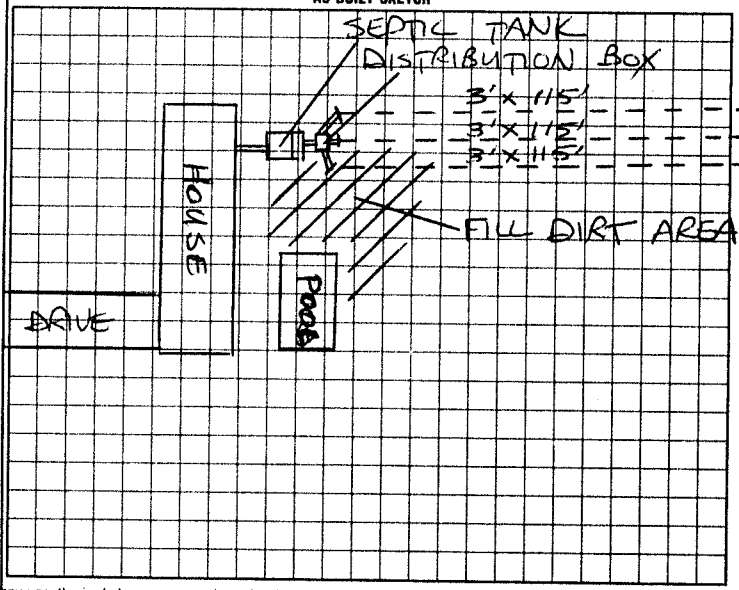

I understand that this permit can be suspended or revoked if any false information is supplied toward securing the permit/any unauthorized changes are made to the site/any unauthorized changes are made in the installation of the system. Improvement Permit is valid for 60 months from date of issuance.

Signed: ____

Improvement Permit by: ____ date ____

Existing System Inspection by: STEVE HEDRICK date 8/23/94

Installed by: ____

Certificate of Completion by: ____ date ____

Operation Permit by: ____ date ____

HEALTH DEPT. COPY: WHITE INSPECTION COPY (FINAL): GREEN OWNER COPY (FINAL): YELLOW INSPECTION COPY (INITIAL): PINK OWNER COPY (INITIAL): GOLD