IREDELL COUNTY HEALTH DEPARTMENT

STATESVILLE 704-878-5305 MOORESVILLE 704-664-5281

IMPROVEMENT PERMIT / AUTHORIZATION TO CONSTRUCT / OPERATION PERMIT / EXISTING SYSTEM INSPECTION

PERMIT# REPAIR PIN# 4725-58-6361 52716 DATE 11-29-06

OWNER OR APPLICANT RONALD W. WILLIAMS PHONE: Business Home 704-873-6980

ADDRESS 281 MILLER FARM ROAD, STATESVILLE, NC 28625-8700

LOCATION NC 115 NORTH, TL SCOTTS CREEK RD, TL MILLER FARM RD, DRIVEWAY ON RIGHT ACROSS FROM DOVE MEADOWS

SUBDIVISION BLOCK / SECTION LOT LOT AREA 5.29 ACRES SITE CLASS. PS DESIGN FLOW 480 L.T.A.R. 0.30 GPD/FT2

Septic Tank: 1000 Gallons; STB WP 1007 Date 9-11-06

Pump Tank: Gallons; PT Date

Pump Make: Model Serial No.

Nitrification Field: No Fields 1 Square Feet EQ. P 1600 Linear Feet 400

No Lines THREE Trench Width 36" Max Trench Bottom Depth 36"

☑ New System ☑ Repair ☐ Expansion System Type: I (II) III IV V VI

System Description:

Repair System Description: 25% REDUCTION, GRAVITY

Maintenance Agreement Required: ☐ Yes ☑ No

☑ House/Mod. Home No. Bedrooms 4

☐ Mobile Home No. Persons

☐ Business No. Employees

☐ Other


Water Supply: ☑ Individual ☐ Public ☐ Community WELL

Gravel Depth N/A ☑ Gravity ☐ Pressure ☐ Slab ☑ Crawl Space ☑ Basement w/plumbing ☐ Basement wo/plumbing


Comments:/Conditions ① INSTALL NEW SEPTIC TANK W/RISERS, NO DEEPER THAN 36" ② INSTALL 3" SCH 40 PVC SUPPLY LINE AT LEAST 30" DEEP OR USE DUCTILE IRON ③ INSTALL NEW 25% REDUCTION SYSTEM AS FLAGGED ON SITE.

Comments:/Conditions: Nos marker / Filter installed

INITIAL SITE SKETCH

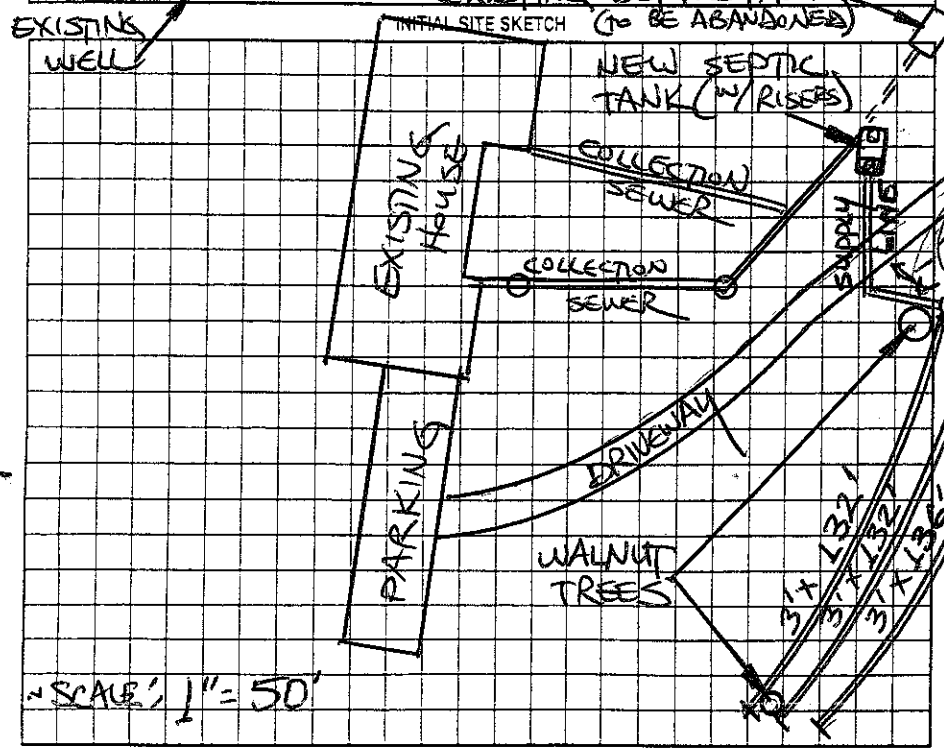

AS BUILT SKETCH

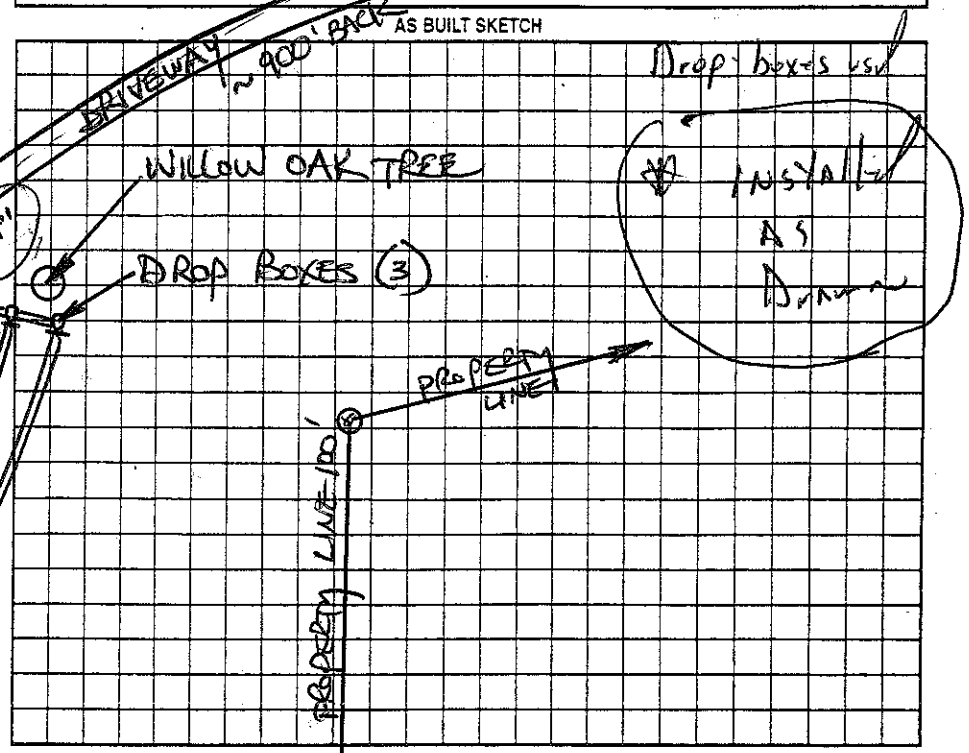

Permit can be suspended or revoked if any false information is supplied toward securing the permit/any unauthorized changes are made to the site/any unauthorized changes are made in the installation of the system. Improvement Permit with plat valid without expiration ☐ Improvement Permit with site plan valid for sixty months ☑ Authorization to Construct is valid for a period equal to that of Improvement Permit – not to exceed sixty months.

Signed: Ronald W. Williams date 11-29-06 Installed by: James Huddler

Improvement Permit by: STEVE HEDRICK date 11-29-06 Operation Permit by: Jim Nuggs, RS date 12-07-06

Authorization to Construct by: STEVE HEDRICK date 11-29-06 Existing System Inspection by: date

HEALTH DEPT. COPY: WHITE OWNER COPY (FINAL): YELLOW OWNER COPY (INITIAL): PINK