IREDELL COUNTY HEALTH DEPARTMENT

STATESVILLE 704-878-5305 CI MOORESVILLE 704-664-5281

IMPROVEMENT PERMIT / AUTHORIZATION TO CONSTRUCT / OPERATION PERMIT / EXISTING SYSTEM INSPECTION

PERMIT# 112710 PIN# 4725-58-6704 DATE 5/23/03

OWNER OR CONTRACTOR Standard Building Company, Inc PHONE: Business (704) 902-4618 Home —

ADDRESS 167 Barringer Drive Statesville N.C. 28625

LOCATION Hwy 115 N, (L) Scotts Creek Rd (L) Miller Farm Rd, (R) Beech Brook, 4th lot on left.

SUBDIVISION Piney Oaks BLOCK / SECTION — LOT 45 LOT AREA .916 Ac SITE CLASS. 75' DESIGN FLOW 360 L.T.A.R. .35

Septic Tank: 1,000 Gallons; STB 1017 Date 4-16-03
Pump Tank: 1000 Gallons; PT 17 Date 7-22-03
Pump Make: Solids Model WE0311M Serial No. J0 3603189
Nitrification Field: No Fields 1 Square Feet 1029 Linear Feet 360
No Lines 4 @ 90 Ft Trench Width 36" Max Trench Bottom Depth 36" Gravel Depth 12"

☒ New System ☐ Repair System Type: I, II, (III), IV, V, VI
System Description: Pump, Conventional
Repair System Description: Pump, 25% Reduction
Maintenance Agreement Required: ☐ Yes ☐ No


☒ House/Mod. Home No. Bedrooms 3
☐ Mobile Home No. Bathrooms 2
☐ Business No. Employees ___
☐ Other ___
☐ Slab ☒ Crawl Space ☐ Basement w/plumbing ☐ Basement wo/plumbing

Water Supply: ☐ Individual ☒ Public ☐ Community

Comments:/Conditions:

Comments:/Conditions: ① SEPTIC TANK WITH MARKER INSTALLED USING "TUFFTITE" FILTER ② TANKS & LINES INSPECTED 10-30-03, RSH. Pressure check, Electrical + Alarm OKay 12/16/03 wf

INITIAL SITE SKETCH

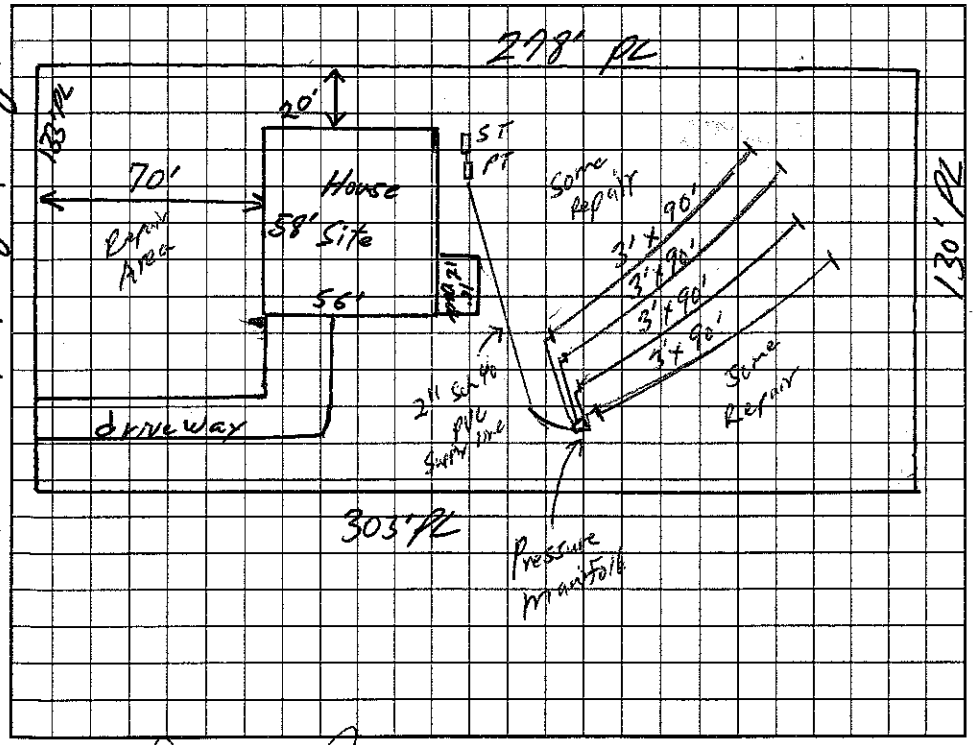

AS BUILT SKETCH

Installed As Shown per Initial Site Sketch

Beech Brook Lane R/W

Permit can be suspended or revoked if any false information is supplied toward securing the permit/any unauthorized changes are made to the site/any unauthorized changes are made in the installation of the system. Improvement Permit with plat valid without expiration. Improvement Permit with site plan valid for sixty months. Authorization to Construct is valid for a period equal to that of Improvement Permit – not to exceed sixty months.

Signed: wm Nelson date 5/27/2003 Installed by: STEVE JORDAN, PIEDMONT BACKHOE

Improvement Permit by: William O. Johnson date 5/23/03 Operation Permit by: William O. John date 12/16/03

Authorization to Construct by: William O. John date ___ Existing System Inspection by: ___ date ___

HEALTH DEPT. COPY: WHITE OWNER COPY (FINAL): YELLOW OWNER COPY (INITIAL): PINK