IREDELL COUNTY HEALTH DEPARTMENT

Statesville Office (704) 878-5305 Mooresville Office (704) 660-3625 PERMIT # 213950

IMPROVEMENT PERMIT / AUTHORIZATION TO CONSTRUCT / OPERATION PERMIT / EXISTING SYSTEM

PIN # 4725586704

APPLICANT: Ron Conklin APPLICANT ADDRESS: 133 Beech Brook Ln

SITE ADDRESS: 133 Beech Brook Ln PHONE: 704-682-5206 ALT. PHONE: 989-860-4556

SITE DIRECTIONS: 115 N T/L Scotts Creek T/L Miller Farm Rd T/R Beech Brook Lot on left

SUBDIVISION: Piney Oaks SECTION: N/A LOT # 45 LOT AREA: .916ac DESIGN FLOW: Ex L.T.A.R.: Ex

Septic Tank	Ex	(gal)	STB		Date				
Pump Tank		(gal)	PT		Date				
Pump Make		Model			Serial #				
# Nitrification Fields	Ex	# Lines	Ex	Linear Ft:	Ex				
Trench Width	Ex	Max. Trench Bottom Depth	Ex	Gravel Depth	Ex				

☐ New System ☐ Repair ☐ Expansion System Type: I ☒ II III IV V VI

System Description: Existing

Repair System Description:


Maintenance Agreement Required: ☐ YES ☒ NO ☐ GRAVITY ☒ PRESSURE

☒ Residence No. Bedrooms Ex ☐ Business No. Persons Ex ☐ Other No. Employees ☐ Slab ☒ Crawl Space ☐ Basement w/plumbing ☐ Basement w/o plumbing


Water Supply: ☐ Private ☒ Public ☐ Community

Comments / Conditions: All building foundations must be 55' from any part of STS

INITIAL SITE SKETCH

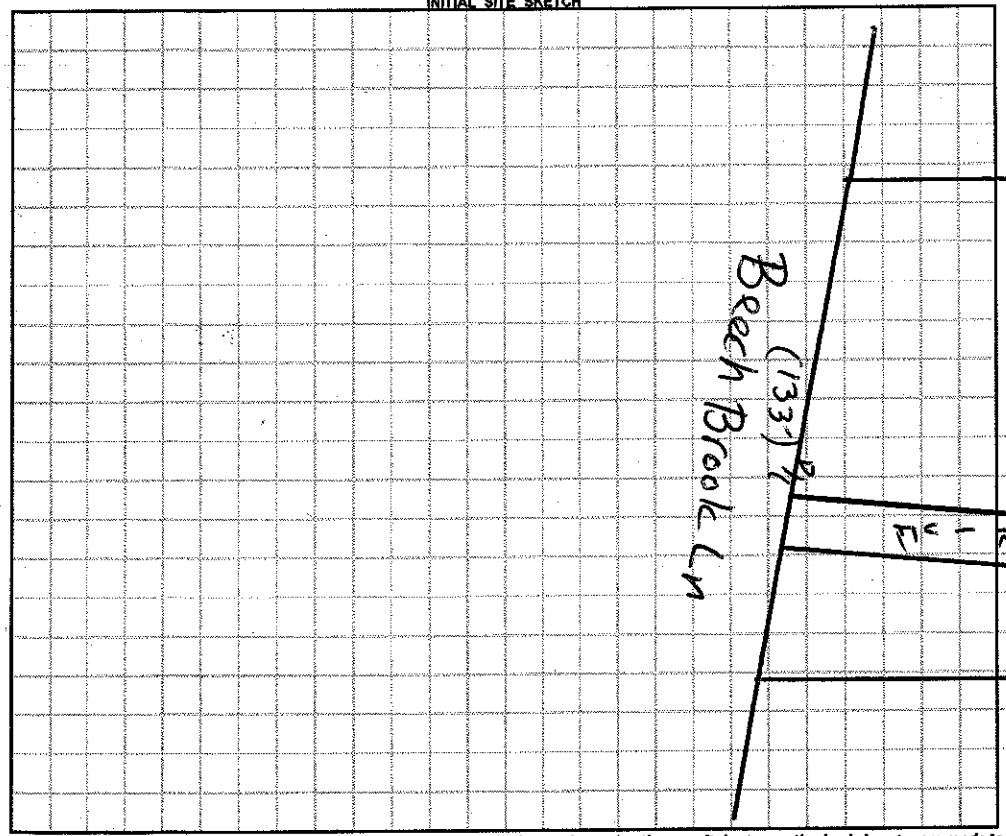

AS BUILT SKETCH

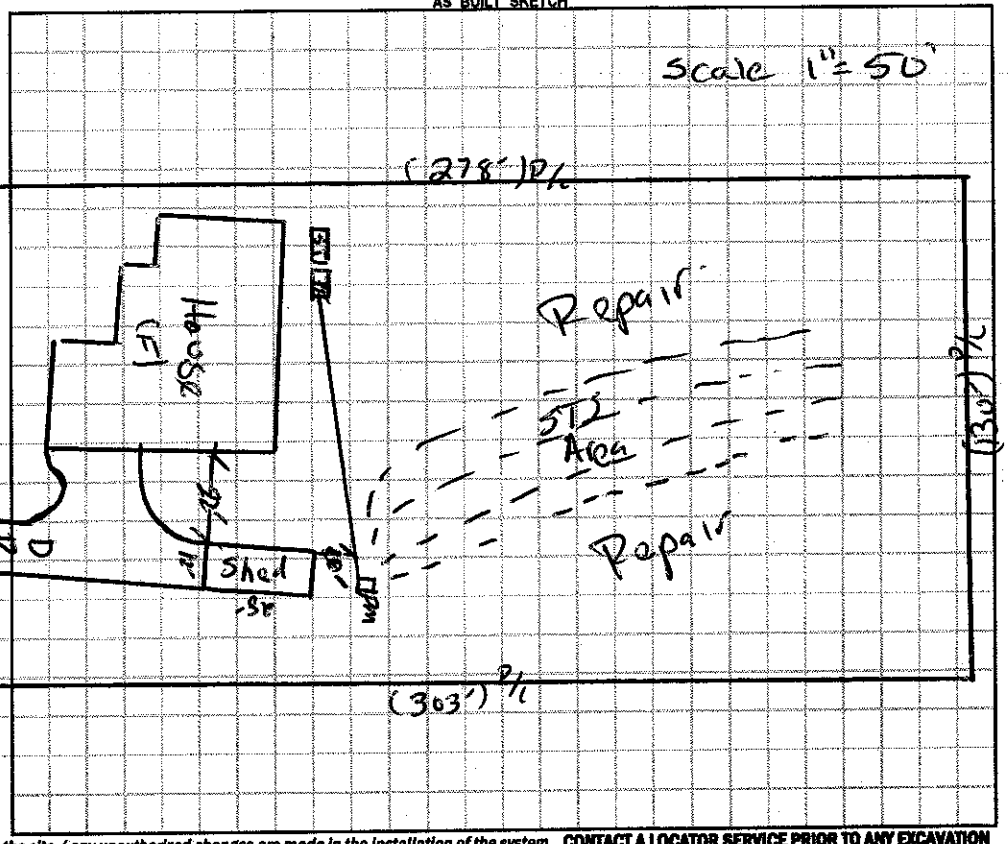

Permit can be suspended or revoked if any false information is supplied toward securing the permit / any unauthorized changes are made to the site / any unauthorized changes are made in the installation of the system. **CONTACT A LOCATOR SERVICE PRIOR TO ANY EXCAVATION**

☐ **IMPROVEMENT PERMIT** *with plat valid without expiration.* ☐ **IMPROVEMENT PERMIT** *with site plan valid for 60 mos.* ☐ **AUTHORIZATION TO CONSTRUCT** *valid for period equal to IMPROVEMENT PERMIT--not to exceed 60 mo.*

Owner / Applicant Signature: Ron Conklin Date: 10/14/15 Installed by:

IMPROVEMENT PERMIT by: Date: OPERATION PERMIT by: Date:

AUTHORIZATION TO CONSTRUCT by: Date: Existing System Inspected by: David Adams Date: 10/09/15

Health Dept. Copy - WHITE Applicant (Final Approval) - YELLOW Applicant (Conditional Approval) - PINK