IREDELL COUNTY HEALTH DEPARTMENT

STATESVILLE 704-878-5305 MOORESVILLE 704-664-5281

IMPROVEMENT PERMIT / AUTHORIZATION TO CONSTRUCT / OPERATION PERMIT / EXISTING SYSTEM INSPECTION

PERMIT# 13284/2 PIN# 4725588753 DATE 1-6-06

OWNER OR CONTRACTOR Rick Hobbs PHONE: Business Home 704-873 6945

ADDRESS 119 Beech Brook Ln

LOCATION Hwy 115, left Old W. Ikesboro Rd, 1st Forks in road.

SUBDIVISION Piney Oaks BLOCK / SECTION LOT 47 LOT AREA .867 SITE CLASS PS DESIGN FLOW 360 L.T.A.R. .3

Septic Tank: 1000 Gallons; STB 1007 Date 4-14-06
Pump Tank: Gallons; PT Date
Pump Make: Model Serial No.
Nitrification Field: No Fields 1 Square Feet 1200 Linear Feet 300
No Lines 4 Trench Width 36" Max Trench Bottom Depth 36" Gravel Depth

☒ New System ☐ Repair System Type: I II III IV V VI
System Description: 25% Reduction Gravity
Repair System Description: 25% Reduction Pump
Maintenance Agreement Required: ☐ Yes ☒ No

☒ House/Mod. Home No. Bedrooms 3
☐ Mobile Home No. Bathrooms
☐ Business No. Employees
☐ Other


☐ Slab ☒ Crawl Space ☐ Basement w/plumbing ☐ Basement wo/plumbing

Water Supply:
☐ Individual
☐ Public
☒ Community


Comments:/Conditions:

Comments:/Conditions:
Bonico - Orange Hyeson gutter
Septic tank North

INITIAL SITE SKETCH

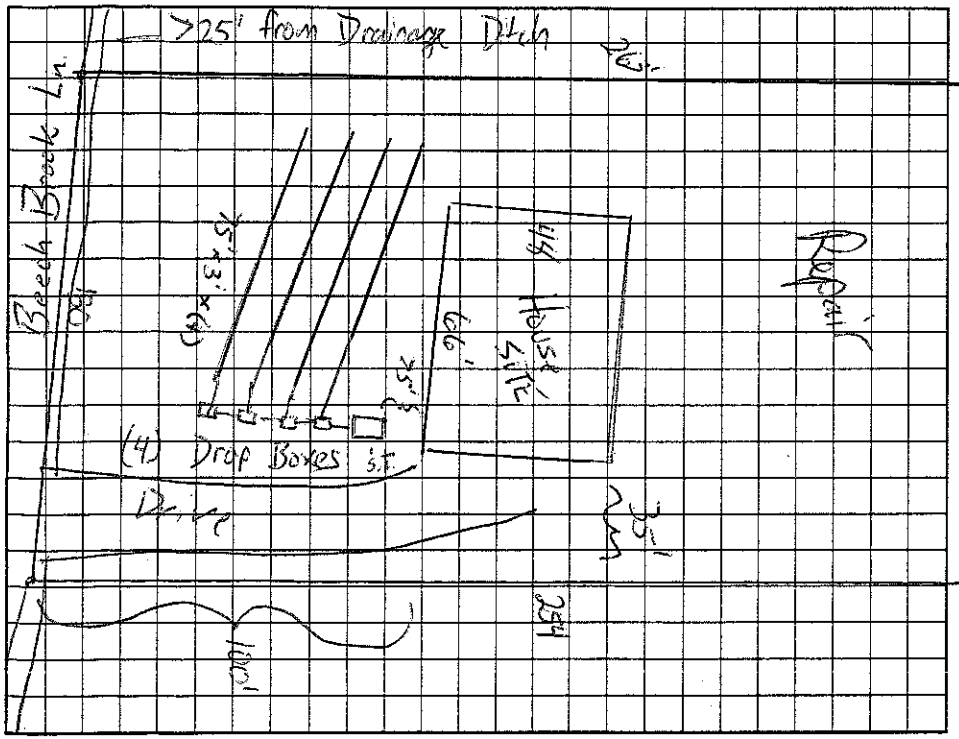

AS BUILT SKETCH

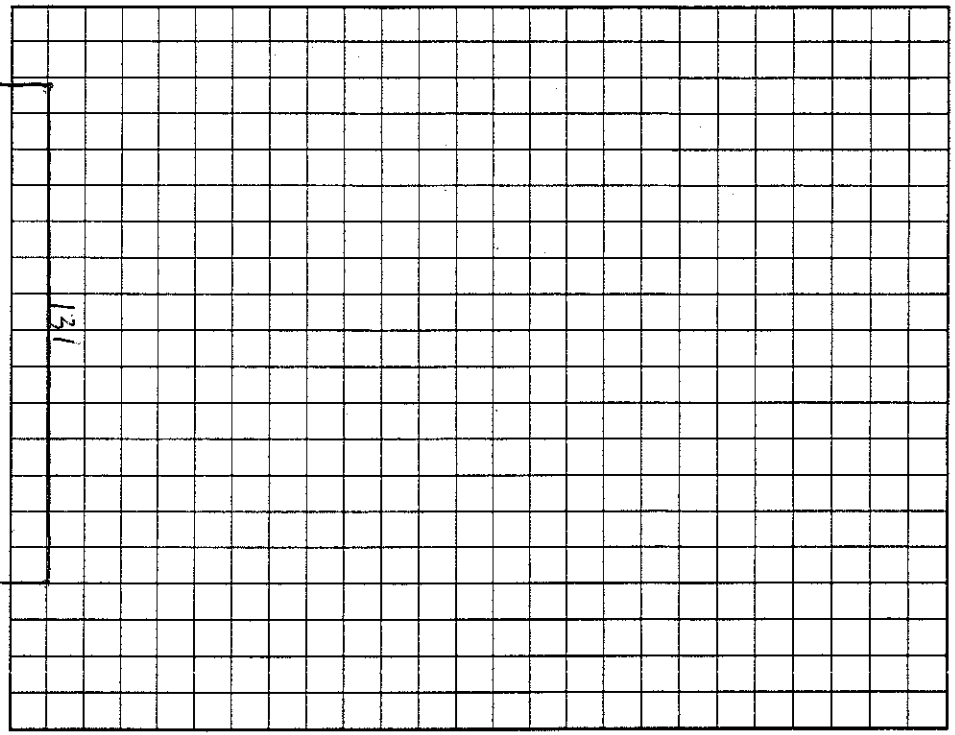

Permit can be suspended or revoked if any false information is supplied toward securing the permit/any unauthorized changes are made to the site/any unauthorized changes are made in the installation of the system. Improvement Permit with plat valid without expiration. Improvement Permit with site plan valid for sixty months. Authorization to Construct is valid for a period equal to that of Improvement Permit – not to exceed sixty months.

Signed: Ricky R. Hobbs date 1/6/06 Installed by: Derek Barnes

Improvement Permit by: James Dawson date 1-6-06 Operation Permit by: Kelly Cox date 5-25-06

Authorization to Construct by: James Dawson date 1-6-06 Existing System Inspection by: date

HEALTH DEPT. COPY: WHITE OWNER COPY (FINAL): YELLOW OWNER COPY (INITIAL): PINK