IREDELL COUNTY HEALTH DEPARTMENT

Statesville Office (704) 878-5305 Mooresville Office (704) 660-3625 PERMIT # 211308

IMPROVEMENT PERMIT / AUTHORIZATION TO CONSTRUCT / OPERATION PERMIT / EXISTING SYSTEM

PIN # 4725593143

APPLICANT: Barry Sechrist APPLICANT ADDRESS: 303 N. Center St.

SITE ADDRESS: 146 Beech Brook PHONE: 704-500-6612 ALT. PHONE: N/A

SITE DIRECTIONS: Hwy 115 N TL Scotts Creek Rd TL Miller Farm Rd TR Beech Brook Rd.

SUBDIVISION: Piney Oaks SECTION: N/A LOT # 6 LOT AREA: 1.05 acres DESIGN FLOW: 360gpd L.T.A.R.: Existing

Septic Tank 1000 (gal) STB 166-1000 Date 4-13-15
Pump Tank (gal) PT Date
Pump Make Model Serial #
Nitrification Fields Ex # Lines Ex Linear Ft: Ex
Trench Width Ex Max. Trench Bottom Depth Ex Gravel Depth Ex


☐ New System ☑ Repair ☐ Expansion System Type: I (II) III IV V VI
System Description: TANK
Repair System Description:
Maintenance Agreement Required: ☐ YES ☑ NO ☑ GRAVITY ☐ PRESSURE

☑ Residence No. Bedrooms 3
☐ Business No. Persons 6
☐ Other No. Employees
☐ Slab ☑ Crawl Space
☐ Basement w/plumbing ☐ Basement w/o plumbing


Water Supply: ☐ Private ☑ Public ☐ Community

Comments / Conditions: Pump & crush existing septic tank. Set new septic tank @ location shown below & connect to existing drainfield.

INITIAL SITE SKETCH

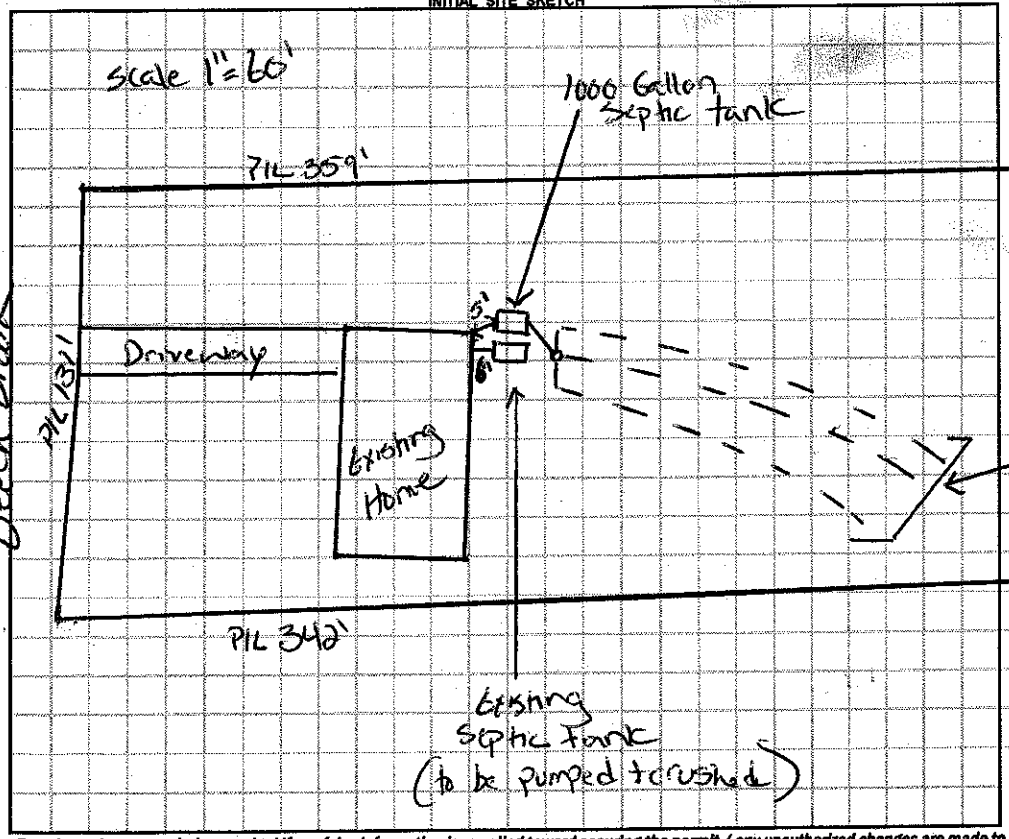

AS BUILT SKETCH

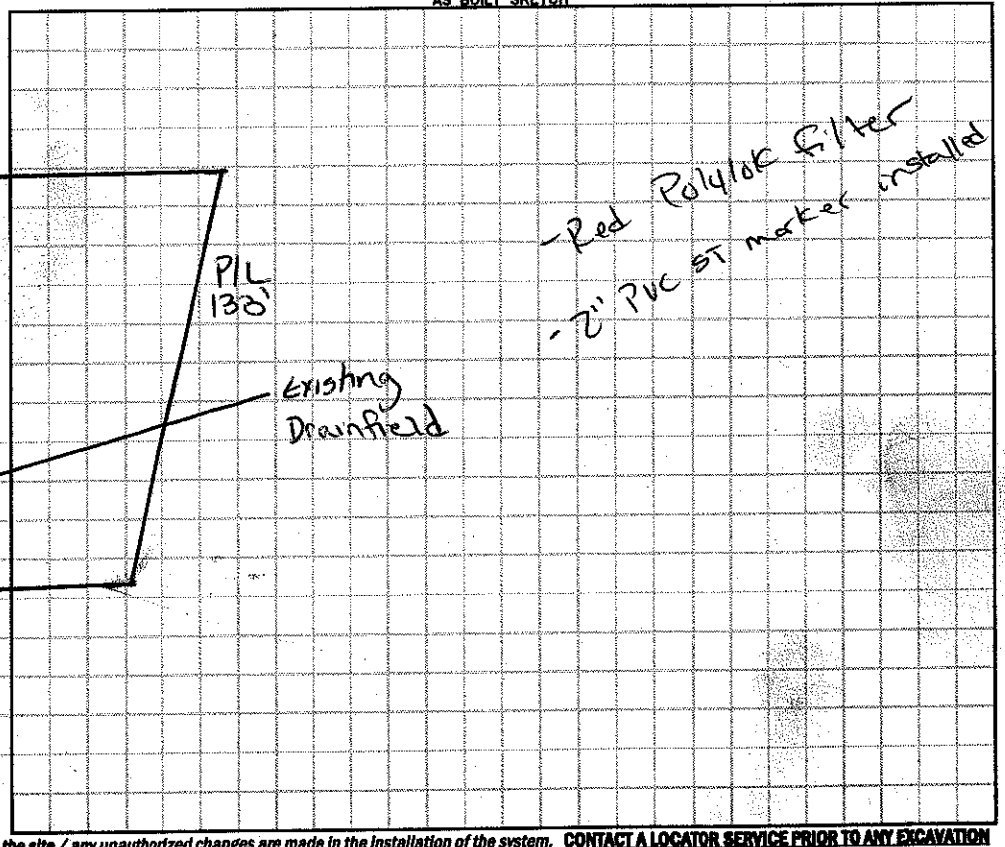

Permit can be suspended or revoked if any false information is supplied toward securing the permit / any unauthorized changes are made to the site / any unauthorized changes are made in the installation of the system. **CONTACT A LOCATOR SERVICE PRIOR TO ANY EXCAVATION**

☐ **IMPROVEMENT PERMIT** *with plat valid without expiration.* ☑ **IMPROVEMENT PERMIT** *with site plan valid for 60 mos.* ☑ **AUTHORIZATION TO CONSTRUCT** *valid for period equal to IMPROVEMENT PERMIT--not to exceed 60 mo.*

Owner / Applicant Signature: Barry Sechrist Date: 6-18-15 Installed by: K+M Grading

IMPROVEMENT PERMIT by: Justin Henderson Date: 6-17-15 OPERATION PERMIT by: Justin Henderson Date: 6-25-15

AUTHORIZATION TO CONSTRUCT by: Justin Henderson Date: 6-17-15 Existing System Inspected by: Date:

Health Dept. Copy - WHITE Applicant (Final Approval) - YELLOW Applicant (Conditional Approval) - PINK