46137

IREDELL COUNTY HEALTH DEPARTMENT

STATESVILLE 704-878-5305 MOORESVILLE 704-664-5281

IMPROVEMENT PERMIT / CERTIFICATE OF COMPLETION / OPERATION PERMIT / EXISTING SYSTEM INSPECTION

PROPERTY DESCRIPTION NO. 15693 DATE 6/25/93 TAX MAP NO. 9D-13-A-6

OWNER OR CONTRACTOR ACORN DEV. INC. PHONE: Business _____ Home _____

ADDRESS _____

LOCATION NC 90 W, TR MONTICELLO DR, TL MILLER FARM RD, TL BEECH BROOK LN, 6TH ON R

SUBDIVISION _____ BLOCK / SECTION _____ LOT _____ LOT AREA 132'X355' SITE CLASS. PS L.T.A.R. 0.35 GPD/FT²

Water Supply: ☐ Individual ☐ Community ☒ Public

Septic Tank: 1000 Gallons; STB 1012 Date 4/13/93

Pump Tank: _____ Gallons; PT _____ Date _____

Nitrification Field: No Fields _____ Square Feet _____ Linear Feet _____

No Lines _____ Trench Width _____ Trench Depth _____ Gravel Depth _____

☐ New System ☐ Repair System Type: I, II, III, IV, V, VI

System Description: CONV. GRAVITY

Repair System Description: _____

Maintenance Agreement Required: ☐ Yes ☒ No

☒ House/Mod. Home ☐ Mobile Home ☐ Business ☐ Other _____

No. Bedrooms 3 No. Bathrooms 2 No. Employees _____

Garbage Disposal: ☐ Yes ☒ No

Auto. Dishwasher: ☒ Yes ☐ No

Auto. Washing Machine: ☒ Yes ☐ No


Other _____

☐ Slab ☒ Crawl Space ☐ Basement w/plumbing ☐ Basement wo/plumbing

Comments SEPTIC TANK LOCATION SHIFTED DUE TO STUB-OUT CHANGE

INITIAL SITE SKETCH

AS BUILT SKETCH

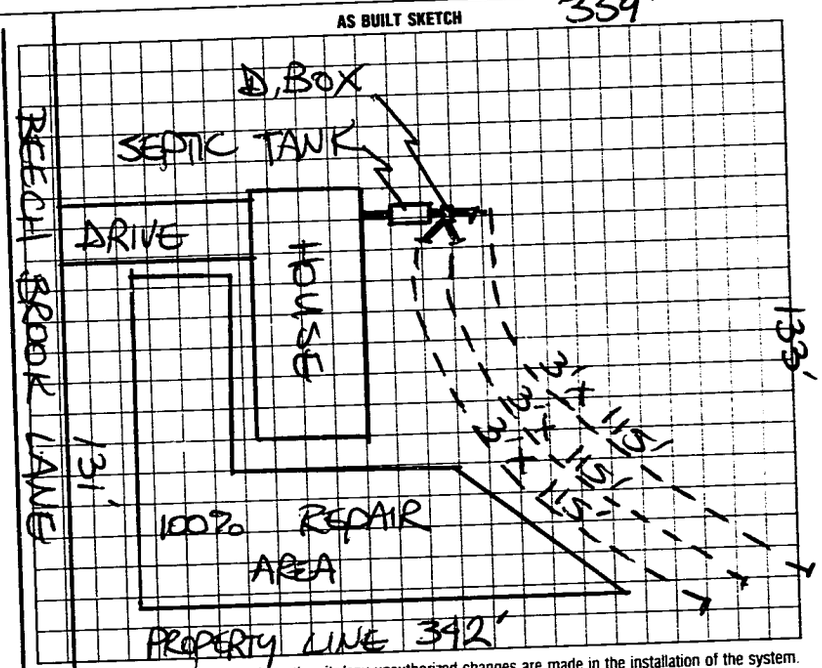

I understand that this permit can be suspended or revoked if any false information is supplied toward securing the permit/any unauthorized changes are made to the site/any unauthorized changes are made in the installation of the system. Improvement Permit is valid for 60 months from date of issuance.

Signed: _____

Improvement Permit by: STEVE HEDRICK date 6/25/93

Existing System Inspection by: _____ date _____

Installed by: JAMES HUNTER

Certificate of Completion by: STEVE HEDRICK date 6/25/93

Operation Permit by: _____ date _____

HEALTH DEPT. COPY: WHITE INSPECTION COPY (FINAL): GREEN OWNER COPY (FINAL): YELLOW INSPECTION COPY (INITIAL): PINK OWNER COPY (INITIAL): GOLD