IREDELL COUNTY HEALTH DEPARTMENT

STATESVILLE 704-878-5305 MOORESVILLE 704-664-5281

IMPROVEMENT PERMIT / AUTHORIZATION TO CONSTRUCT / OPERATION PERMIT / EXISTING SYSTEM INSPECTION

PERMIT# REPAIR PIN#

OWNER OR CONTRACTOR DWIGHT & JULIA BOLIN DATE 3-17-98

ADDRESS 2657 FINES CREEK DRIVE, STATESVILLE, NC 28625 PHONE: Business Home 871-9261

LOCATION NC 90 W, TR MONTICELLO DRIVE, SYSTEM BEHIND HOUSE AT BOX # 323

SUBDIVISION BLOCK / SECTION LOT LOT AREA LIMITED SITE CLASS. PS DESIGN FLOW 600 L.T.A.R. 0.30 GPD/FT²

Septic Tank: 1500 Gallons; STB 268 Date 2-1-98

Pump Tank: Gallons; PT Date

Pump Make: Model Serial No.

Nitrification Field: No Fields 1 Square Feet REQ 2000 Linear Feet 504

No Lines SIX Trench Width 36" Max Trench Bottom Depth 36" Gravel Depth 6" SAND

☐ New ☑ Repair System Type: I, II, III, IV, V, VI

System Description: CHAMBERED GRAVITY

Repair System Description: CHAMBERED GRAVITY

Maintenance Agreement Required: ☐ Yes ☑ No

☑ House/Mod. Home (1) No. Bedrooms 5

☑ Mobile Home (1) No. Bathrooms

☐ Business No. Employees

☐ Other TWO DWELLINGS


☐ Slab ☑ Crawl Space ☐ Basement w/plumbing ☐ Basement wo/plumbing

Water Supply: ☐ Individual ☐ Public ☐ Community


Comments:/Conditions: ① INSTALL 84 CHAMBERS IN SIX EQUAL LENGTH LINES AS SHOWN ③ INSTALL ACCESS RISERS OVER EACH MANHOLE EXTENDING AT LEAST 6" ABOVE FINISHED GRADE

Comments:/Conditions:

INITIAL SITE SKETCH SCALE: 1"=40'

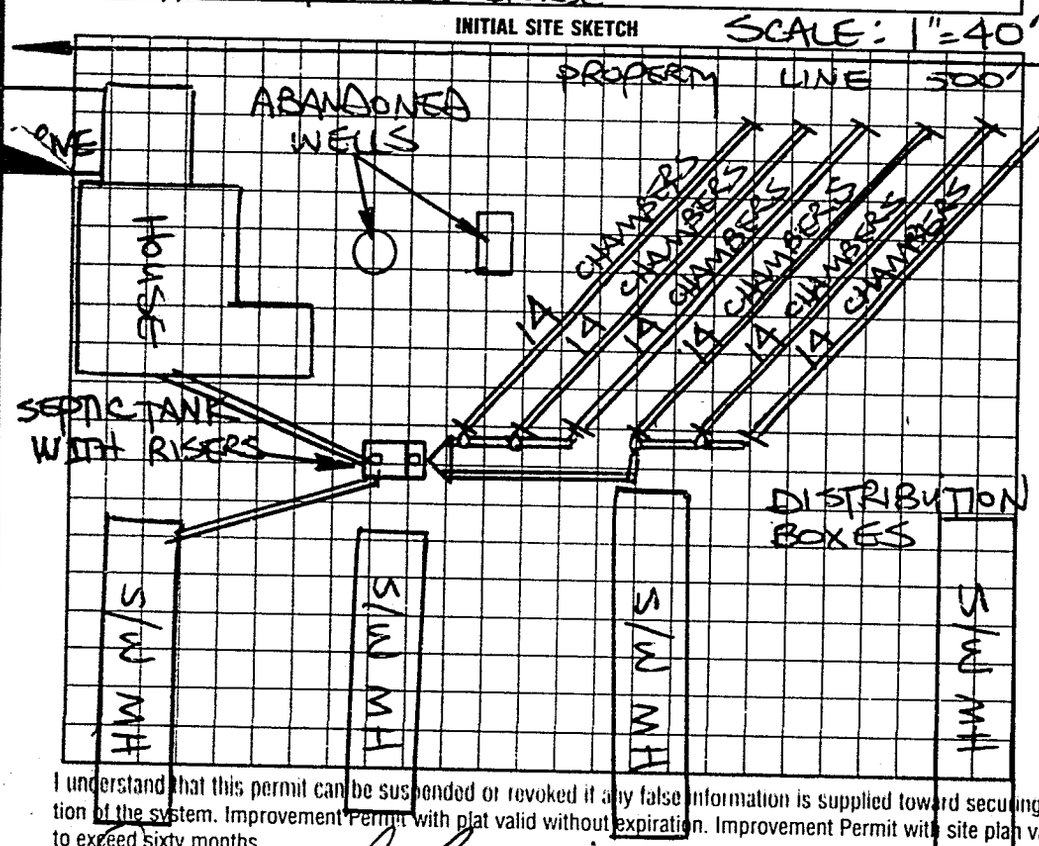

AS BUILT SKETCH

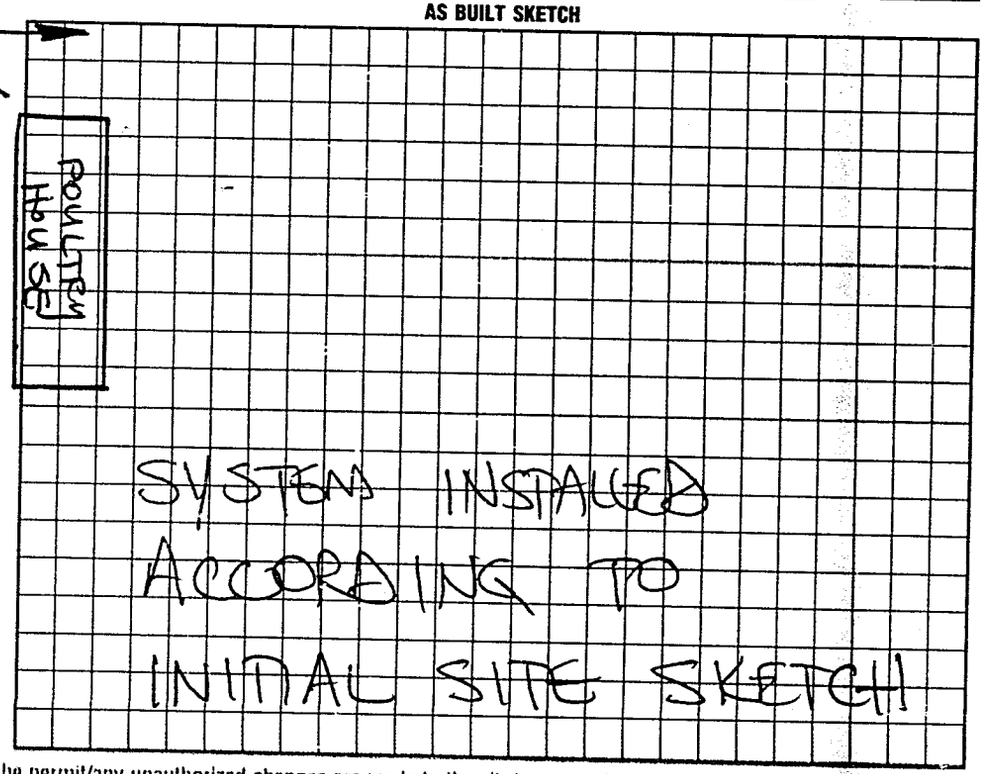

I understand that this permit can be suspended or revoked if any false information is supplied toward securing the permit/any unauthorized changes are made to the site/any unauthorized changes are made in the installation of the system. Improvement Permit with plat valid without expiration. Improvement Permit with site plan valid for sixty months. Authorization to Construct is valid for a period equal to that of Improvement Permit – not to exceed sixty months.

Signed: Julia R Bolin date 3-17-98

Improvement Permit by: STEVE HEDRICK date 3-17-98

Authorization to Construct by: STEVE HEDRICK date 3-17-98

Installed by: BARRY SIGMON

Operation Permit by: STEVE HEDRICK date 5-20-98

Existing System Inspection by: - date

HEALTH DEPT COPY WHITE INSPECTION COPY (FINAL) GREEN OWNER COPY (FINAL) YELLOW INSPECTION COPY (INITIAL) PINK OWNER COPY (INITIAL) BLUE