IREDELL COUNTY HEALTH DEPARTMENT

THIS PERMIT VOIDS PREVIOUS ISSUED 9/26/94

STATESVILLE 704-878-5305 MOORESVILLE 704-664-5281

IMPROVEMENT PERMIT / CERTIFICATE OF COMPLETION / OPERATION PERMIT / EXISTING SYSTEM INSPECTION

PROPERTY DESCRIPTION NO. CITY DATE 12/6/94 TAX MAP NO. 6K-20-A-8 (PART OF) Watershed: ☐ Yes ☑ No

OWNER OR CONTRACTOR CRANDALL & O'BRIEN PHONE: Business 871-1536 Home

ADDRESS RT. 2, BOX 266 STATESVILLE, NC 28677

LOCATION NC 90 W, TR MONTICELLO, TL MILLER FARM 3RD LOT ON RIGHT

SUBDIVISION SUNNYDALE BLOCK / SECTION I LOT 27-2 LOT AREA ~181 X 110 SITE CLASS. PS DESIGN FLOW 360 L.T.A.R. 0.35 GPD/FT²

Septic Tank: 1000 Gallons; STB 794 Date 4/24/95

Pump Tank: Gallons; PT Date

Pump Make: Model Serial No.

Nitrification Field: No Fields 1 Square Feet 1035 Linear Feet 345

No Lines 4 Trench Width 36" Max Trench Bottom Depth 18-36" Gravel Depth 12"

☑ New System ☐ Repair System Type: I, II, III, IV, V, VI

System Description: CONVENTIONAL GRAVITY

Repair System Description: CONV. GRAVITY

Maintenance Agreement Required: ☐ Yes ☑ No

☑ House/Mod. Home ☐ Mobile Home ☐ Business ☐ Other

No. Bedrooms 3 No. Bathrooms 2 No. Employees


☐ Slab ☑ Crawl Space ☐ Basement w/plumbing ☐ Basement wo/plumbing

Water Supply: ☐ Individual ☐ Community ☑ Public

Comments:

Comments: P# 53820

INITIAL SITE SKETCH

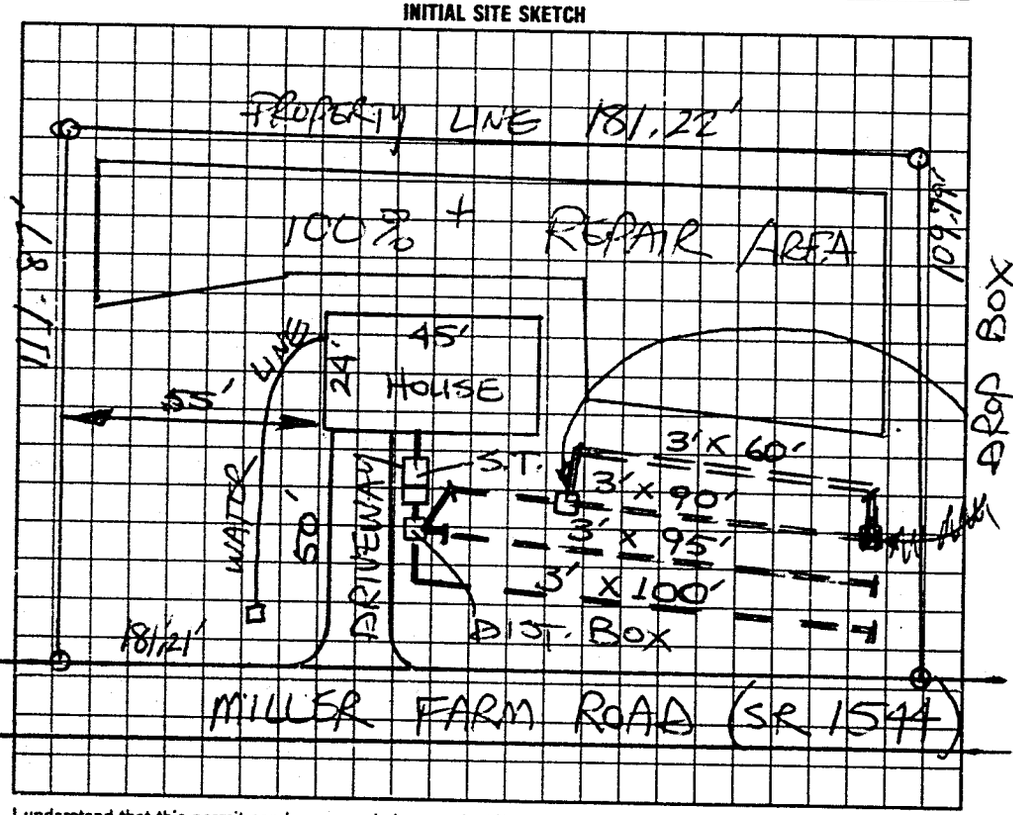

AS BUILT SKETCH

SYSTEM INSTALLED ACCORDING TO INITIAL SITE SKETCH

I understand that this permit can be suspended or revoked if any false information is supplied toward securing the permit/any unauthorized changes are made to the site/any unauthorized changes are made in the installation of the system. Improvement Permit is valid for 60 months from date of issuance.

Signed: Richard Crandall

Improvement Permit by: STEVE HEDRICK date 12/6/94

Existing System Inspection by: date

Installed by: A-1 BACKHOE

Certificate of Completion by: STEVE HEDRICK date 6/15/95

Operation Permit by: date

HEALTH DEPT. COPY WHITE INSPECTION COPY (FINAL) GREEN OWNER COPY (FINAL) YELLOW INSPECTION COPY (INITIAL) PINK OWNER COPY (INITIAL) GOLD