IREDELL COUNTY HEALTH DEPARTMENT

Statesville Office (704) 878-5305 Mooresville Office (704) 660-3625 PERMIT # 206689

IMPROVEMENT PERMIT / AUTHORIZATION TO CONSTRUCT / OPERATION PERMIT / EXISTING SYSTEM

PIN # 4725650406

APPLICANT: Abee's Clearing + Grading APPLICANT ADDRESS: 2381 US 64 W Mocksville NC 27028

SITE ADDRESS: 149 Miller Farm Rd Statesville NC 28625 PHONE: 704-239-3693 ALT. PHONE: N/A

SITE DIRECTIONS: (L) Bradley Farm (L) monticello (R) miller Farm Lot on left


SUBDIVISION: Sunnydale SECTION: 51 LOT # 16 LOT AREA: 0.687ac DESIGN FLOW: 360 L.T.A.R.: 0.3

Septic Tank	1000 (gal)	STB	760	Date	1-11-14	[X] New System [ ] Repair [ ] Expansion	System Type: I II [III] IV V VI	[X] Residence	No. Bedrooms 3
Pump Tank	N/A (gal)	PT	N/A	Date	N/A	System Description:	25% Reduction	[ ] Business	No. Persons 6
Pump Make	N/A	Model	Polylok	Serial #	PL-68	Repair System Description:	50% Reduction	[ ] Other	No. Employees
# Nitrification Fields	1	# Lines	3	Linear Ft:	300	Maintenance Agreement Required:	[ ] YES [X] NO	[ ] Slab	[X] Crawl Space
Trench Width	36"	Max. Trench Bottom Depth	36"	Gravel Depth	N/A		[X] GRAVITY [ ] PRESSURE	[ ] Basement w/plumbing	[ ] Basement w/o plumbing


Water Supply: [ ] Private [X] Public [ ] Community

Comments / Conditions: Install 25% Reduction on contour with serial distribution. Grade out terrace to maintain positive drainage

INITIAL SITE SKETCH

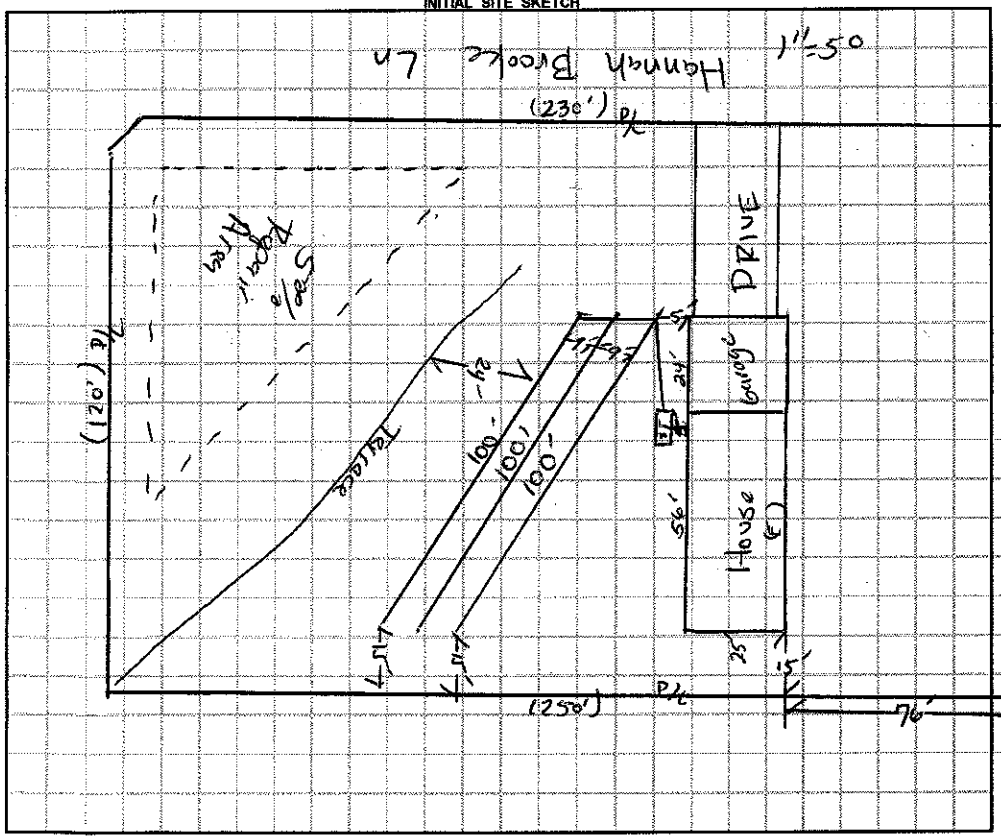

AS BUILT SKETCH

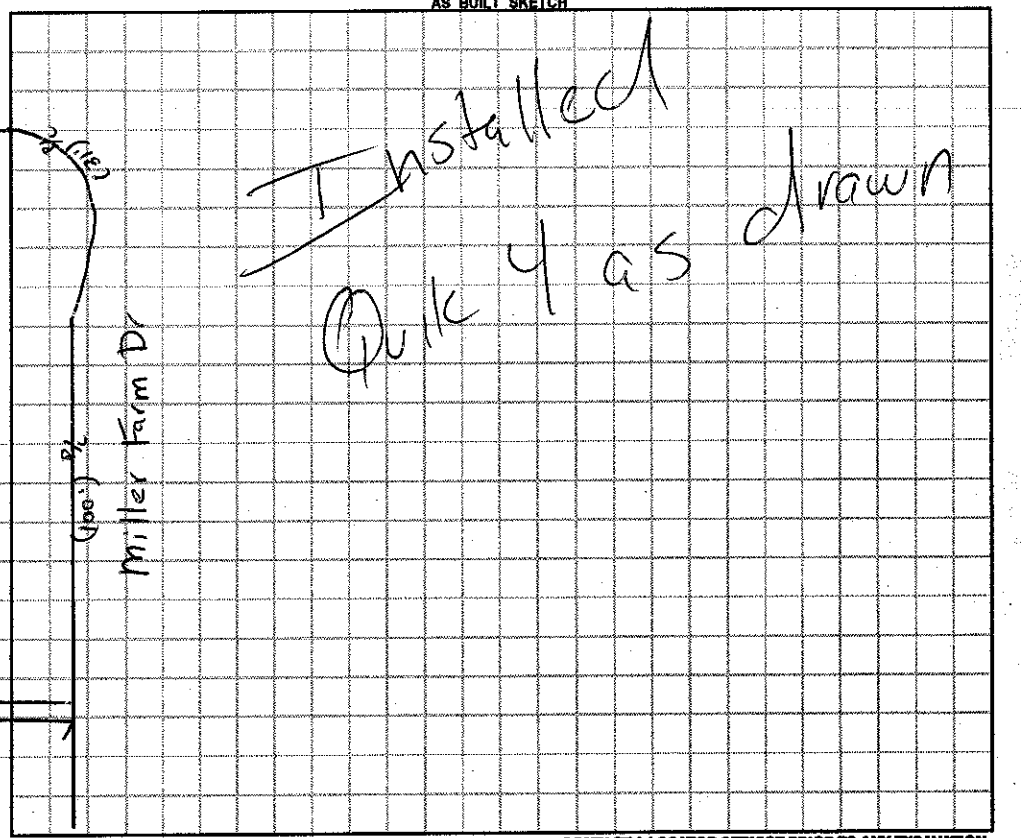

Permit can be suspended or revoked if any false information is supplied toward securing the permit / any unauthorized changes are made to the site / any unauthorized changes are made in the installation of the system. **CONTACT A LOCATOR SERVICE PRIOR TO ANY EXCAVATION**

[ ] **IMPROVEMENT PERMIT** *with plat valid without expiration.* [X] **IMPROVEMENT PERMIT** *with site plan valid for 60 mos.* [X] **AUTHORIZATION TO CONSTRUCT** *valid for period equal to IMPROVEMENT PERMIT--not to exceed 60 mo.*

Owner / Applicant Signature: Deera Abee Date: 12/4/14 Installed by: Abee's Clearing + Grading

IMPROVEMENT PERMIT by: David A Date: 12/04/14 OPERATION PERMIT by: David A Date: 05/20/14

AUTHORIZATION TO CONSTRUCT by: David A Date: 12/04/14 Existing System Inspected by: Date:

Health Dept. Copy - WHITE Applicant (Final Approval) - YELLOW Applicant (Conditional Approval) - PINK