IREDELL COUNTY HEALTH DEPARTMENT

STATESVILLE 704-878-5305 ✓ MOORESVILLE 704-664-5281

IMPROVEMENT PERMIT / AUTHORIZATION TO CONSTRUCT / OPERATION PERMIT / EXISTING SYSTEM INSPECTION

PERMIT# 094913 PIN# 4725650603 DATE 3/12/01

OWNER OR CONTRACTOR James L. Jones PHONE: Business — Home (704) 873-2150

ADDRESS 124 Monte Vista Road, Statesville N.C. 28625

LOCATION 115 N @ Scotts Creek @ in Milky Fork, on Corner of Hannah Brooke Lane

SUBDIVISION Sunnydale BLOCK / SECTION — LOT 13 LOT AREA .60 Acre SITE CLASS. B5 DESIGN FLOW 360 L.T.A.R. .25

Septic Tank: 1000 Gallons: STB 1000 Date 10-2-01
Pump Tank: — Gallons: PT — Date —
Pump Make: — Model — Serial No. —
Nitrification Field: No Fields 1 Square Feet 1440 Linear Feet 480
No Lines 8@60' Trench Width 36" Max Trench Bottom Depth 30" Gravel Depth 12"

X New System X Repair System Type: I II III IV V VI
System Description: Gravity Conventional
Repair System Description: Pump, 60% Reduction
Maintenance Agreement Required: ☐ Yes ☐ No

X House/Mod. Home ☐ Mobile Home ☐ Business ☐ Other
No. Bedrooms 3 No. Bathrooms 2 No. Employees —


☐ Slab X Crawl Space ☐ Basement w/plumbing ☐ Basement wo/plumbing

Water Supply: ☐ Individual X Public ☐ Community


Comments/Conditions: ① Install lines on Contour ② Keep lines 10ft From Property Lines

Comments/Conditions: - Septic Tank Marker Installed
- Poly Tote Filter Installed

INITIAL SITE SKETCH Not to Scale

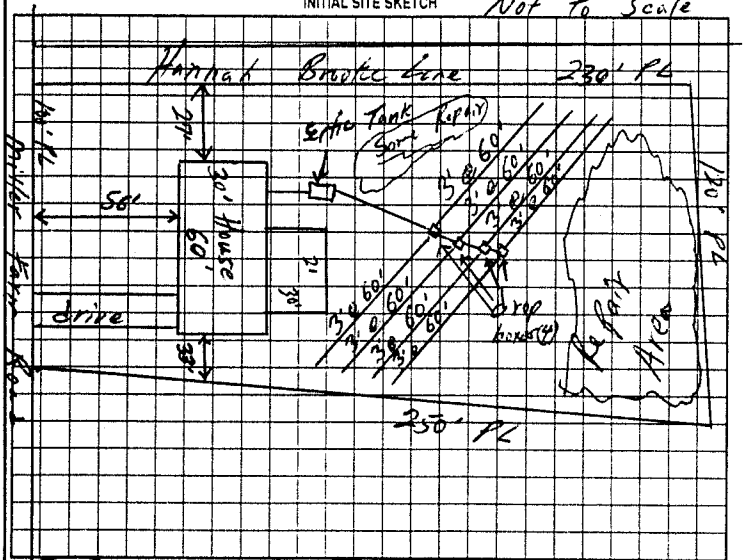

AS BUILT SKETCH

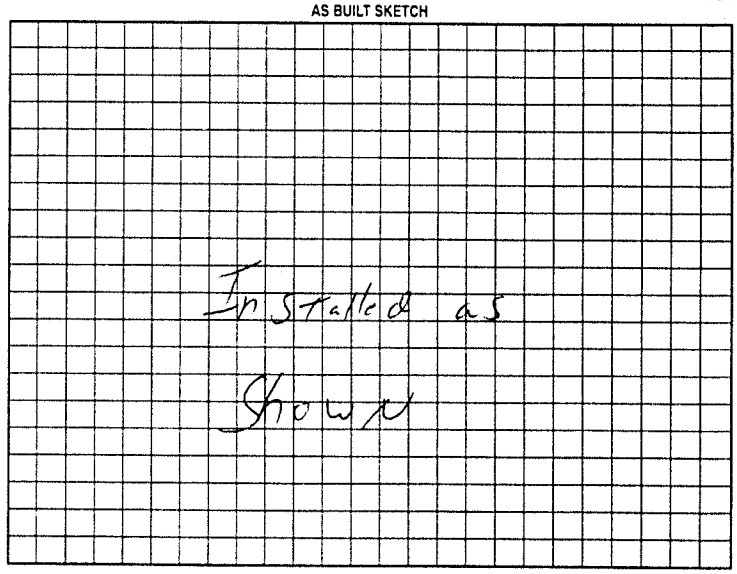

Permit can be suspended or revoked if any false information is supplied toward securing the permit/any unauthorized changes are made to the site/any unauthorized changes are made in the installation of the system. Improvement Permit with plat valid without expiration. Improvement Permit with site plan valid for sixty months. Authorization to Construct is valid for a period equal to that of Improvement Permit – not to exceed sixty months.

Signed: James L Jones date 3/12/01 Installed by: James Hucker

Improvement Permit by: William O. Johnson E.S. date 3/12/01 Operation Permit by: William O. Johnson date —

Authorization to Construct by: William O Johnson date 3/12/01 Existing System Inspection by: — date —

HEALTH DEPT. COPY WHITE OWNER COPY (FINAL) YELLOW OWNER COPY (INITIAL) PINK