IREDELL COUNTY HEALTH DEPARTMENT

Statesville Office (704) 878-5305 Mooresville Office (704) 660-3625 PERMIT # 218066

IMPROVEMENT PERMIT / AUTHORIZATION TO CONSTRUCT / OPERATION PERMIT / EXISTING SYSTEM

PIN # 4725652065

APPLICANT: Barbara Setzer APPLICANT ADDRESS: 130 Miller Farm Rd

SITE ADDRESS: 130 Miller Farm Rd PHONE: 704-872-3838 ALT. PHONE: N/A

SITE DIRECTIONS: Hwy 115 N TL Old Wilkesboro Rd TL Monticello Rd, TR Miller Farm Rd, 1st Brick House on R

SUBDIVISION: N/A SECTION: N/A LOT # N/A LOT AREA: 0.96 acres DESIGN FLOW: Existing L.T.A.R.: Existing

Septic Tank 1000 (gal) STB 760-1000 Date 2-15
Pump Tank (gal) PT Date
Pump Make Model Serial #
Nitrification Fields Ex # Lines Ex Linear Ft: Ex
Trench Width Ex Max. Trench Bottom Depth Ex Gravel Depth Ex


☐ New System ☑ Repair ☐ Expansion System Type: I (II) III IV V VI
System Description: TANK
Repair System Description:
Maintenance Agreement Required: ☐ YES ☑ NO
☑ GRAVITY ☐ PRESSURE

☑ Residence No. Bedrooms Ex
☐ Business No. Persons Ex
☐ Other No. Employees
☐ Slab ☐ Crawl Space
☑ Basement w/plumbing ☐ Basement w/o plumbing


Water Supply: ☐ Private ☑ Public ☐ Community

Comments / Conditions: Pump & crush existing septic tank. Remove mulch/flower garden @ location of new septic tank. Install new tank @ location shown below & connect to existing drainfield. Install Risers if tank is deeper than 6"

INITIAL SITE SKETCH

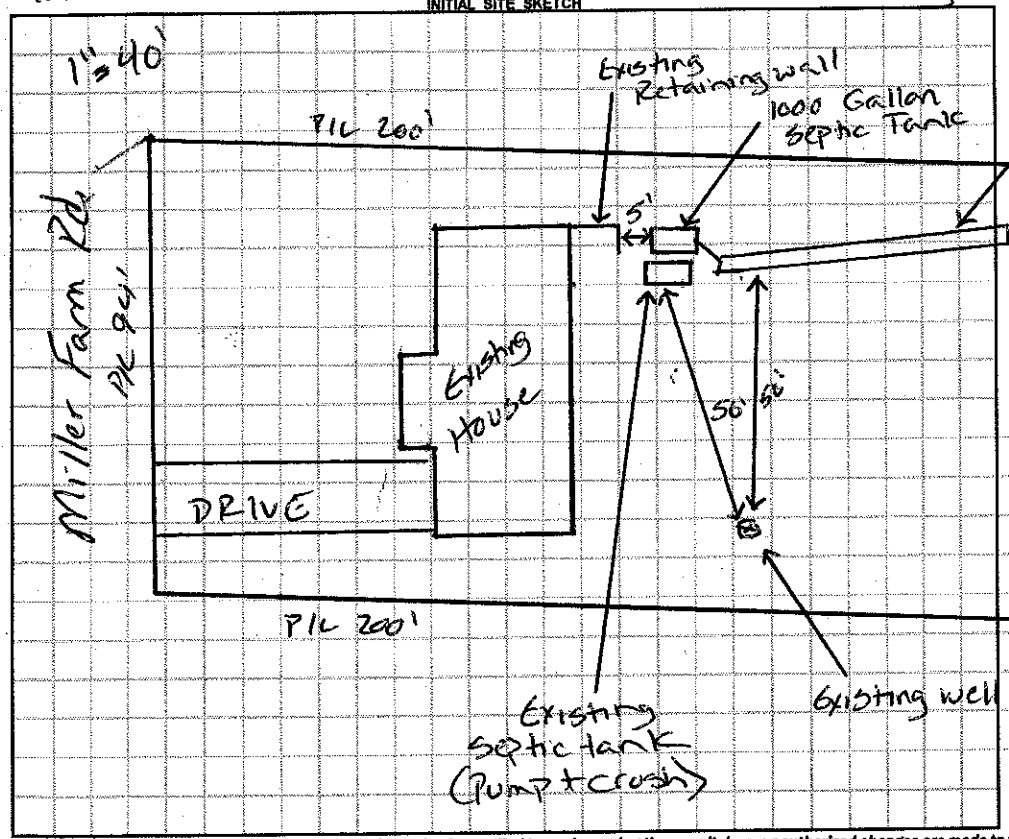

AS BUILT SKETCH

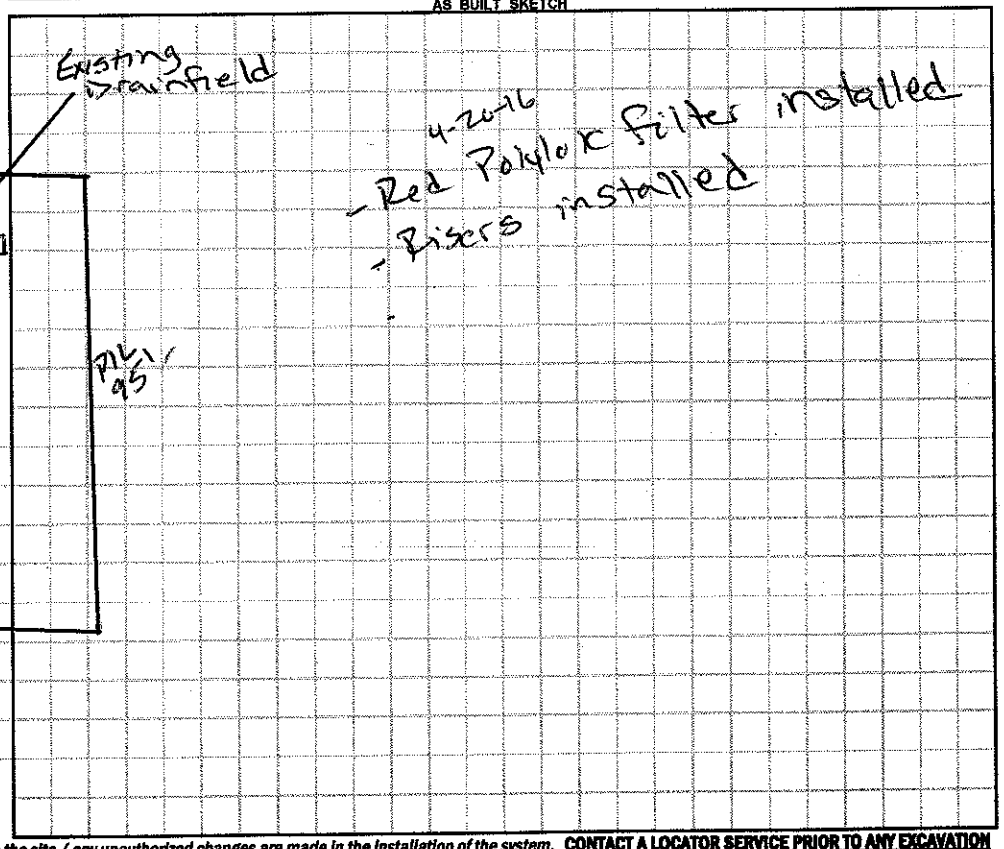

Permit can be suspended or revoked if any false information is supplied toward securing the permit / any unauthorized changes are made to the site / any unauthorized changes are made in the installation of the system. **CONTACT A LOCATOR SERVICE PRIOR TO ANY EXCAVATION**

☐ **IMPROVEMENT PERMIT** *with plat valid without expiration.* ☑ **IMPROVEMENT PERMIT** *with site plan valid for 60 mos.* ☑ **AUTHORIZATION TO CONSTRUCT** *valid for period equal to IMPROVEMENT PERMIT--not to exceed 60 mo.*

Owner / Applicant Signature: Date: Installed by: A1 - Backhoe

IMPROVEMENT PERMIT by: Justin Henderson Date: 4-19-16 OPERATION PERMIT by: Justin Henderson Date: 4-20-16

AUTHORIZATION TO CONSTRUCT by: Justin Henderson Date: 4-19-16 Existing System Inspected by: Date:

Health Dept. Copy - WHITE Applicant (Final Approval) - YELLOW Applicant (Conditional Approval) - PINK