IREDELL COUNTY HEALTH DEPARTMENT

STATESVILLE 704-878-5305 MOORESVILLE 704-664-5281

IMPROVEMENT PERMIT / AUTHORIZATION TO CONSTRUCT / OPERATION PERMIT / EXISTING SYSTEM INSPECTION

PERMIT# REPAIR PIN# DATE 1-20-00

OWNER OR CONTRACTOR ERVIN KEATON PHONE: Business Home 872-3334

ADDRESS 168 MILLER FARM ROAD, STATESVILLE, NC 28625

LOCATION NC 90W, TR MONTICELLO DR, TL MILLER FARM ROAD, HOUSE ON RIGHT AT BOX #168

SUBDIVISION BLOCK / SECTION LOT LOT AREA LIMITED SITE CLASS PS DESIGN FLOW 360 L.T.A.R. EXISTING

Septic Tank EXISTING Gallons; STB Date

Pump Tank: Gallons; PT Date

Pump Make: Model Serial No.

Nitrification Field: No Fields 1 Square Feet 720 Linear Feet 240

No Lines FOUR Trench Width 36" Max Trench Bottom Depth 36" Gravel Depth (18")

☐ New System ☑ Repair System Type: I (II) III. IV. V. VI

System Description: CONVENTIONAL GRAVITY

Repair System Description: CONV. GRAVITY

Maintenance Agreement Required: ☐ Yes ☑ No

☑ House/Mod. Home No. Bedrooms 3

☐ Mobile Home No. Bathrooms

☐ Business No. Employees


☐ Other

☐ Slab ☑ Crawl Space ☐ Basement w/plumbing ☐ Basement wo/plumbing

Water Supply: ☑ Individual ☐ Public ☐ Community WELL


Comments/Conditions: ① REPLACE SANITARY TEE IN SEPTIC TANK ② INSTALL NEW SUPPLY LINE (3" x 90') ③ INSTALL NEW DRAINLINES AS SHOWN USING 18" STONE ④ THIS PERMIT SERVES AS NOTICE OF VIOLATION - SYSTEM TO BE REPAIRED BY 2-20-00

INITIAL SITE SKETCH

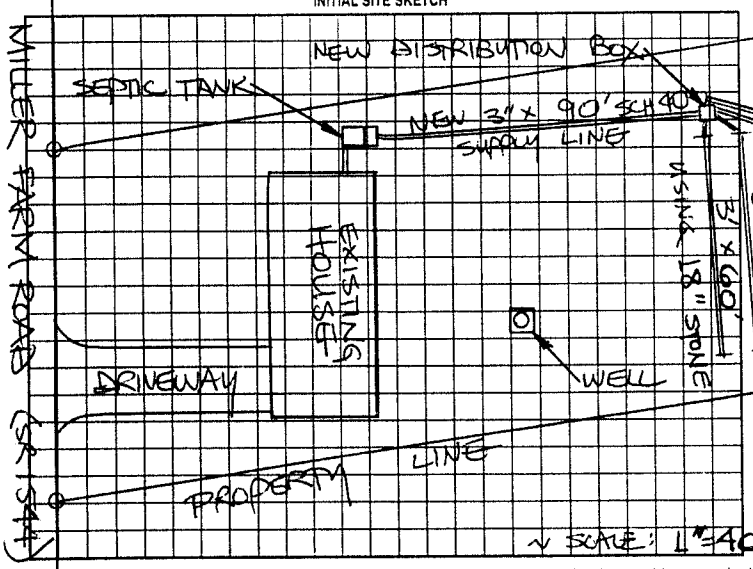

Comments/Conditions: ① SEPTIC TANK PUMPED-OUT 2-17-00 ② SANITARY TEE REPLACED

AS BUILT SKETCH

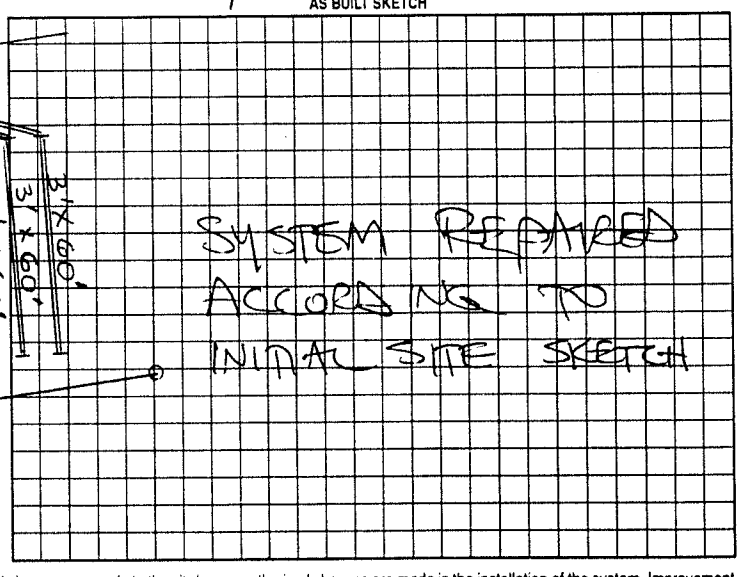

Permit can be suspended or revoked if any false information is supplied toward securing the permit/any unauthorized changes are made to the site/any unauthorized changes are made in the installation of the system. Improvement Permit with plat valid without expiration. Improvement Permit with site plan valid for sixty months. Authorization to Construct is valid for a period equal to that of Improvement Permit – not to exceed sixty months.

Signed: Erwin Keaton date 1-20-00 Installed by: STEVE JORDAN

Improvement Permit by: STEVE HENDRICK date 1-20-00 Operation Permit by: STEVE HENDRICK date 2-17-00

Authorization to Construct by: STEVE HENDRICK date 1-20-00 Existing System Inspection by: date

HEALTH DEPT. COPY: WHITE OWNER COPY (FINAL): YELLOW OWNER COPY (INITIAL): PINK